

PRENTISS
A 59
5-22-73

MISSISSIPPI
BOARD OF WATER COMMISSIONERS
416 North State Street
Jackson, Mississippi 39201

CODED

WATER WELL DRILLERS LOG

5-22 date well completed 1973 Bonds Well Drilling firm name Prentiss county well located

LANDOWNER: Jessie Moore
Bonnaville, Miss.
(mailing address)

description of formations encountered	from	to
Red clay	0	38
Blue clay	38	300
Water Sand	300	354

WELL LOCATION:
sec. 302 T 4 N R 6 E
8 miles West of Bonnaville
(distance) (direction) (nearest town)

WELL PURPOSE: Home
(home, irrigation, municipal, industrial)

WELL COMPLETION DATA:

(1) diameter (inches) 4

(2) total depth (feet) 354

(3) static water level (feet) 140 below above top of ground.

(4) casing Steel, 4.4
(material) (depth)
_____ if telescope see back.
(size)

(5) screen None
(length) (depth to top)
_____ (size) (material)

(6) pump Head on Pump
(HP) (yield gpm)
_____ (type power)

(7) electric log NO
(yes or no)
_____ (organization running log)

(8) how well bottom plugged Open


CODED

DRILLERS REMARKS:

JUN 6 1973

If well telescopes please sketch and show depths.

GROUND LEVEL

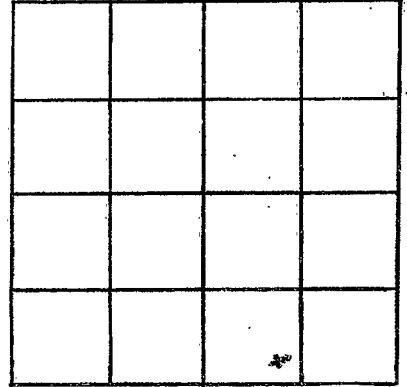

SECTION _____

Please indicate well location X.

ADDITIONAL INFORMATION

If more than one screen,
show locations of each on sketch.