

PRENTISS
A60
8-2-73

MISSISSIPPI
BOARD OF WATER COMMISSIONERS
416 North State Street
Jackson, Mississippi 39201

OCT 19 1973

WATER WELL DRILLERS LOG

8-30-73 1973 Bonds Well Drilling Prentiss BD. OF
date well completed firm name county well located

LANDOWNER: Ottis White
Bonnaville, Miss
(mailing address)

description of formations encountered	from	to
<u>A-16 Red clay</u>	<u>0</u>	<u>16</u>
<u>B-Blue clay</u>	<u>16</u>	<u>300</u>
<u>Water Sand</u>	<u>300</u>	<u>365</u>

WELL LOCATION:
sec. 8 T 4 N R 6 (E)
9 miles NW of Bonnaville
(distance) (direction) (nearest town)

WELL PURPOSE: Home
(home, irrigation, municipal, industrial)


- WELL COMPLETION DATA:
- (1) diameter (inches) 4
 - (2) total depth (feet) 365
 - (3) static water level (feet) 130 below above top of ground.
 - (4) casing Steel 21'
(material) (depth)
 if telescope see back.
(size)
 - (5) screen None
(length) (depth to top)
 (size) (material)
 - (6) pump 2 5
(HP) (yield gpm)
Electric
(type power)
 - (7) electric log NO
(yes or no)
 (organization running log)
 - (8) how well bottom plugged Open

CODED

DRILLERS REMARKS:

If well telescopes please sketch and show depths.

GROUND LEVEL

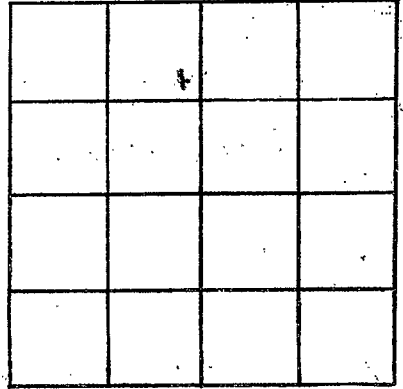

SECTION _____

Please indicate well location X.

ADDITIONAL INFORMATION

If more than one screen, show locations of each on sketch.