

Prentiss  
A 2002  
8-12-80

MISSISSIPPI  
BOARD OF WATER COMMISSIONERS  
416 North State Street  
Jackson, Mississippi 39201

7

WATER WELL DRILLERS LOG

8-12 1980 BombWell Drilling Prentiss  
date well completed firm name county well located

LANDOWNER: <u>Josie Young</u> <u>Booneville, MS</u>  (mailing address)	description of formations encountered	from	to
	<u>Red clay</u>	<u>0</u>	<u>20</u>
	<u>Yellow sand</u>	<u>20</u>	<u>100</u>
	<u>Blue clay</u>	<u>100</u>	<u>150</u>
	<u>Water sand</u>	<u>150</u>	<u>215</u>
<b>WELL LOCATION:</b> sec. <u>35</u> T <u>4</u> N R <u>6</u> E <u>4</u> miles <u>West</u> of <u>Booneville</u> (distance) (direction) (nearest town)			
<b>WELL PURPOSE:</b> <u>Home</u> (home, irrigation, municipal, industrial)			
<b>WELL COMPLETION DATA:</b>			
(1) diameter (inches) <u>4"</u>			
(2) total depth (feet) <u>215'</u>			
(3) static water level (feet) <u>100</u> <u>below</u> above top of ground.			
(4) casing <u>astic</u> , <u>120'</u> (material) (depth)			
_____ If telescope see back. (size)			
(5) screen _____ (length) (depth to top)			
_____ (size) _____ (material)			
(6) pump <u>3/4</u> <u>10</u> (HP) (yield gpm)			
<u>submersible</u> (type power)			
(7) electric log <u>no</u> (yes or no)			
_____ (organization running log)			
(8) how well bottom plugged <u>open</u>			
DRILLERS REMARKS:			


DEPT. OF NATURAL RESOURCES  
BUREAU OF LAND & WATER RESOURCES

AUG 21 1980

RECEIVED

If well telescopes please sketch and show depths.

GROUND LEVEL

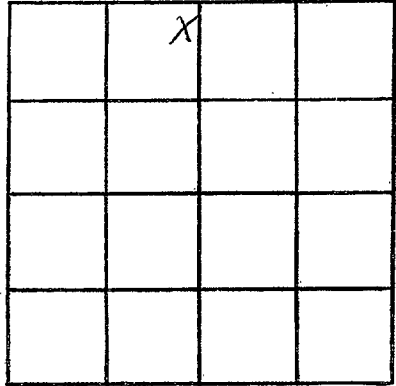

SECTION \_\_\_\_\_

Please indicate well location X.

ADDITIONAL INFORMATION

If more than one screen,  
show locations of each on sketch.