

PRENTISS  
A 2003  
9/19/80

MISSISSIPPI  
BOARD OF WATER COMMISSIONERS  
416 North State Street  
Jackson, Mississippi 39201

WATER WELL DRILLERS LOG

9-19-80 19 Bonds Well Drilling Prentiss  
date well completed firm name county well located

LANDOWNER: Jimmy Nix  
Beonville, MS.

description of formations encountered	from	to
<del>0-55 Red clay</del>		
<del>55-85 Blue</del>		
85-120 Water Sand		

(mailing address)

WELL LOCATION:  
sec. 25 T. 4 N. R. 6 E  
2 miles N of Marietta  
(distance) (direction) (nearest town)

WELL PURPOSE: Home  
(home, irrigation, municipal, industrial)

- WELL COMPLETION DATA:
- (1) diameter (inches) 4"
  - (2) total depth (feet) 120 ft.
  - (3) static water level (feet) 40 below top of ground.
  - (4) casing Plastic, 60 (material) (depth)  
If telescope see back. (size)
  - (5) screen (length) (depth to top)  
(size) (material)
  - (6) pump 3/4 (HP) 10 (yield gpm)  
Elec. (type power)
  - (7) electric log NO (yes or no)  
(organization running log)
  - (8) how well bottom plugged open

DRILLERS REMARKS:


DEPT. OF NATURAL RESOURCES  
BUREAU OF LAND & WATER RESOURCES

MAY 19 1981

RECEIVED

If well telescopes please sketch and show depths.

GROUND LEVEL

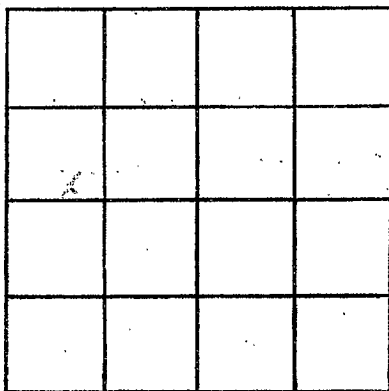

SECTION \_\_\_\_\_

Please indicate well location X.

ADDITIONAL INFORMATION

If more than one screen, show locations of each on sketch.