

Prentiss
B3A
12-66
U.S.G.S.
December 1966

MISSISSIPPI
 BOARD OF WATER COMMISSIONERS
 416 North State Street
 Jackson, Mississippi 39201

CODED

WATER WELL DRILLERS LOG

date well completed 12-66 firm name Herndon-Horankel Supply, Inc. county well located Prentiss Co

LANDOWNER: Shasher
Community Water
System Shasher, Miss
 (mailing address)

WELL LOCATION:
 sec. 23 T. 4 R. 7 E.
SW/4 SW/4 SW/4
 (distance) miles (direction) of (nearest town)

WELL PURPOSE: COMMUNITY
 (home, irrigation, municipal, industrial)

WELL COMPLETION DATA:
 (1) diameter (inches) 8"
 (2) total depth (feet) 514'
 (3) static water level (feet) 176' below top of ground.
 (4) casing steel 434'
 (material) (depth)
8" if telescope see back.
 (size)
 (5) screen 31" 483'
 (length) (depth to top)
4" 304 stainless steel
 (size) (material)
 (6) pump 25 200
 (HP) (yield gpm)
electric
 (type power)
 (7) electric log yes
 (yes or no)
U.S.G.S.
 (organization running log)
 (8) how well bottom plugged Blw

description of formations encountered	from	to
Red clay	0	10
gray clay	10	20
sand	20	25
Blue clay	25	45
sandy Blue clay	45	60
sand	60	90
Blue clay	90	100
sand	100	240
Blue clay	240	310
hard rock	340	341
sand	341	430
gravel	430	480
rock (cherty conchoidal)	480	514
Bottom	514	

APR 30 1967

DRILLERS REMARKS:

MISS. BD. OF
 WATER COMM.

If well telescopes please sketch and show depths.

B34

GROUND LEVEL

434' 9"
8" casing


4" casing

Top of screen
443

31' screen
4"

TD
514

If more than one screen, show locations of each on sketch.

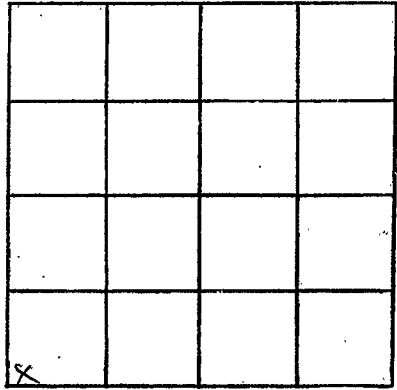

SECTION 23

Please indicate well location X.

ADDITIONAL INFORMATION

Multiple horizontal lines for additional information.