

Prentiss
B 35
68

MISSISSIPPI
BOARD OF WATER COMMISSIONERS
416 North State Street
Jackson, Mississippi 39201

CODED

WATER WELL DRILLERS LOG

19 68 Herndon - Hoiman Prentiss
date well completed firm name county well located

LANDOWNER:	description of formations encountered	from	to
<u>New Cradler Water Ass.</u>			
<u>Booneville, Miss.</u> (mailing address)	<u>Sand Blue Clay</u>	<u>40</u>	<u>80</u>
	<u>Sand</u>	<u>80</u>	<u>152</u>
	<u>Sand w/ shale streaks</u>	<u>152</u>	<u>285</u>
	<u>Blue Clay</u>	<u>285</u>	<u>348</u>
	<u>Sand</u>	<u>348</u>	<u>376</u>
	<u>Pink Gumbo clay</u>	<u>376</u>	<u>400</u>
	<u>Sand</u>	<u>400</u>	<u>460</u>
	<u>Other</u>	<u>460</u>	

WELL LOCATION:
sec. 25 T. 4 N R. 7 E
3 1/2 miles NE of Booneville
(distance) (direction) (nearest town)

WELL PURPOSE: Commercial
(home, irrigation, municipal, industrial)

- WELL COMPLETION DATA:
- (1) diameter (inches) 8
 - (2) total depth (feet) 460
 - (3) static water level (feet) 190 ~~above~~ below top of ground.
 - (4) casing Steel, 360,
(material) (depth)
(size) if telescope see back.
 - (5) screen 42, 373
(length) (depth to top)
4, 304 Stainless
(size) (material)
 - (6) pump 20, 125
(HP) (yield gpm)
electric
(type power)
 - (7) electric log yes
(yes or no)
Miss. Geological Surv.
(organization running log)
 - (8) how well bottom plugged B/W

CODED


MAR 9 - 1970

MISS. BD. OF
WATER COMM.

DRILLERS REMARKS:
Same as last well # 1
Feb. 20, 1968

If well telescopes please sketch and show depths.

GROUND LEVEL

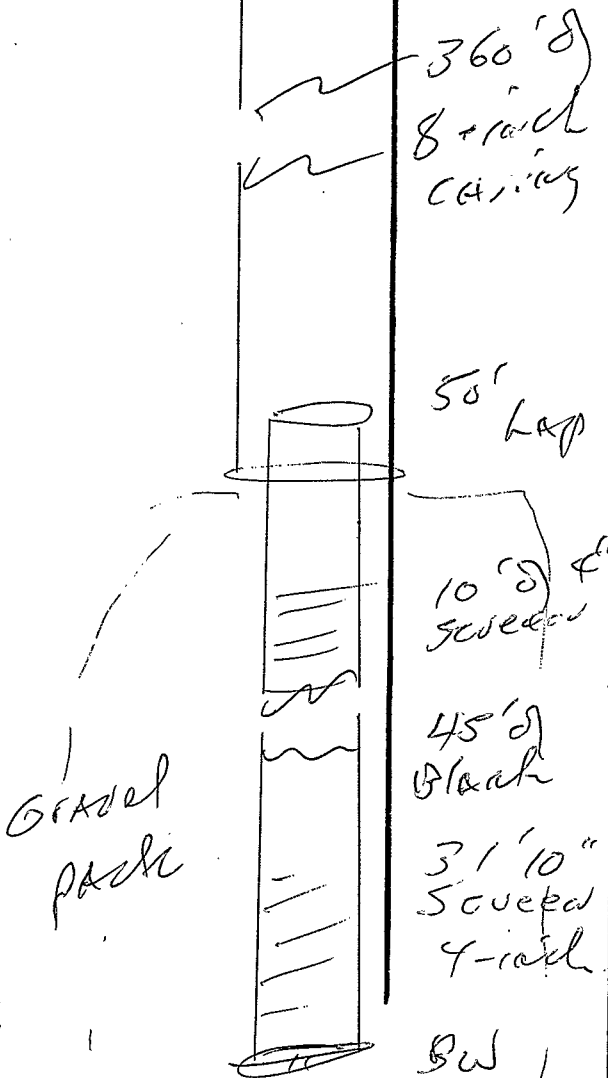

SECTION 25

Please indicate well location X.

ADDITIONAL INFORMATION

If more than one screen, show locations of each on sketch.