

PRENTISS
B36
2-11-71

MISSISSIPPI
BOARD OF WATER COMMISSIONERS
416 North State Street
Jackson, Mississippi 39201

CODED

WATER WELL DRILLERS LOG

2-11 1971 Bond Well Drilling Prentiss
date well completed firm name county well located

LANDOWNER: Lee Mc. Culler

description of formations encountered	from	to

Boonville Miss.
(mailing address)

<u>Washed sand</u>	<u>0</u>	<u>55</u>
<u>Blue clay</u>	<u>55</u>	<u>95</u>
<u>Water sand</u>	<u>95</u>	<u>130</u>

WELL LOCATION:
sec. 10 T. 4 N R. 7 E
6 miles North of Boonville
(distance) (direction) (nearest town)

WELL PURPOSE: Home
(home, irrigation, municipal, industrial)

WELL COMPLETION DATA:

- (1) diameter (inches) 4
- (2) total depth (feet) 130
- (3) static water level (feet) 30 below above top of ground.
- (4) casing Steel 63
(material) (depth)
 if telescope see back.
(size)
- (5) screen iron
(length) (depth to top)
 (size) (material)
- (6) pump 1/4 5
(HP) (yield gpm)
Electric pump
(type power)
- (7) electric log no
(yes or no)
 (organization running log)
- (8) how well bottom plugged open

CODED


MAR 3 1971

DRILLERS REMARKS:

MIS. BD. OF

If well telescopes please sketch and show depths.

GROUND LEVEL

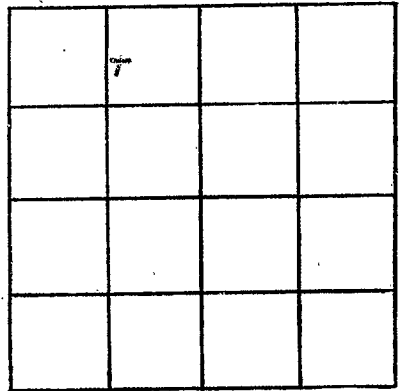

SECTION _____

Please indicate well location X.

ADDITIONAL INFORMATION

If more than one screen,
show locations of each on sketch.