

PRENTISS  
B37  
6-10-71

MISSISSIPPI  
BOARD OF WATER COMMISSIONERS  
416 North State Street  
Jackson, Mississippi 39201

**CODED**

WATER WELL DRILLERS LOG

6-10 date well completed 1971 Bonds Well Drilling firm name Prentiss county well located

LANDOWNER: Joe Wayne White

description of formations encountered

from to

Brownville Miss  
(mailing address)

Red clay  
Blue clay  
Water sand

0 14  
14 172  
172 215

WELL LOCATION:

sec. 18 T. 4 N R. 7 E  
6 miles N-W of Brownville  
(distance) (direction) (nearest town)

WELL PURPOSE: Home  
(home, irrigation, municipal, industrial)

WELL COMPLETION DATA:

(1) diameter (inches) 4  
(2) total depth (feet) 215  
(3) static water level (feet) 60 below above top of ground.

(4) casing Steel 21  
(material) (depth)

(size) If telescope see back.

(5) screen None  
(length) (depth to top)

(size) (material)

(6) pump Hand 0.5 100  
(type power) (yield gpm)

(7) electric log No  
(yes or no)

(organization running log)

(8) how well bottom plugged Open

**CODED**


JUL 14 1971

DRILLERS REMARKS:

MISS. Bd. of  
WATER COMMISSIONERS

If well telescopes please sketch and show depths.

GROUND LEVEL

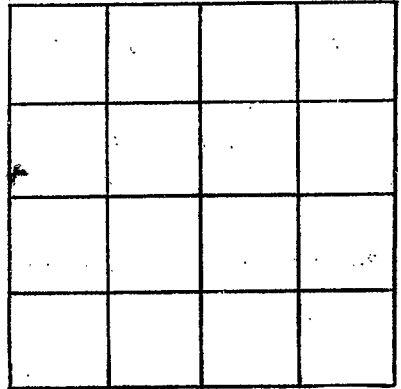

SECTION \_\_\_\_\_

Please indicate well location X.

ADDITIONAL INFORMATION

If more than one screen, show locations of each on sketch.