

Prentiss
B 39
9-24-71

MISSISSIPPI
BOARD OF WATER COMMISSIONERS
416 North State Street
Jackson, Mississippi 39201
WATER WELL DRILLERS LOG

CODED

9-24 date well completed 1971 Bond Well Drilling firm name Prentiss county well located

LANDOWNER: East Lake Wood
Boonville, Miss.
(mailing address)

description of formations encountered	from	to
Red Clay	0	32
Red sand	32	59
Blue clay	59	105
Water sand	105	150

WELL LOCATION:
sec. 10 T. 4 N. R. 7 E.
6 miles North of Boonville
(distance) (direction) (nearest town)

WELL PURPOSE: Home
(home, irrigation, municipal, industrial)

- WELL COMPLETION DATA:
- (1) diameter (inches) 4
 - (2) total depth (feet) 150
 - (3) static water level (feet) 30 below top of ground.
 - (4) casing steel, 63 (material) (depth)
(size) if telescope see back.
 - (5) screen none (length) (depth to top)
(size) (material)
 - (6) pump 3/4 (HP) 5 (yield gpm)
jet pump (type power)
 - (7) electric log no (yes or no)
(organization running log)
 - (8) how well bottom plugged open

CODED


OCT 4 - 1971

DRILLERS REMARKS:

MISS. Bd. of
WATER COMMISSIONERS

If well telescopes please sketch and show depths.

GROUND LEVEL

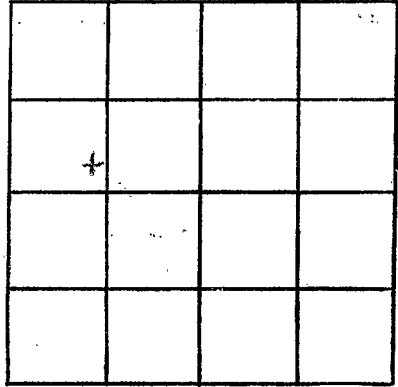

SECTION _____

Please indicate well location X.

ADDITIONAL INFORMATION

If more than one screen, show locations of each on sketch.