

Prentiss

B 40

11-9-71

MISSISSIPPI
 BOARD OF WATER COMMISSIONERS DEC 9 1971
 416 North State Street
 Jackson, Mississippi 39201
 WATER WELL DRILLERS LOG

CODED

MS. BD. OF
WATER COMM


11-9 date well completed 1971 Bond Well Drilling firm name Prentiss county well located

LANDOWNER:	description of formations encountered	from	to
Robert P. Edwards	Red clay	0	38
Brownsville Miss (mailing address)	Blue clay	38	72
	Water sand	72	105
WELL LOCATION:			
sec. 10 T. 4 N R. 7 E			
6 miles North of Brownsville (distance) (direction) (nearest town)			
WELL PURPOSE: Home (home, irrigation, municipal, industrial)			
WELL COMPLETION DATA:			
(1) diameter (inches)	4		
(2) total depth (feet)	105		
(3) static water level (feet)	18	below	above
(4) casing (material)	Steel	(depth)	42
(size)	If telescope see back.		
(5) screen (length)	None	(depth to top)	
(size)	(material)		
(6) pump (HP)	1/2	(yield gpm)	5
(type power)	Electric pump		
(7) electric log (yes or no)	yes		
(organization running log)			
(8) how well bottom plugged	Open		
DRILLERS REMARKS:			

CODED

If well telescopes please sketch and show depths.

GROUND LEVEL

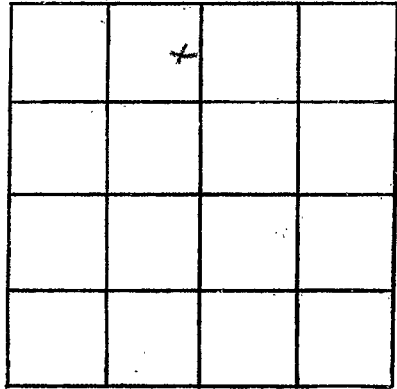

SECTION _____

Please indicate well location X.

ADDITIONAL INFORMATION

Multiple horizontal lines for additional information.

If more than one screen, show locations of each on sketch.