

PRENTISS

B 41

B 41

WATER WELL DRILLERS LOG

4-19-61

Date: April 12, 1961, Driller: HERNDON WELL & SUPPLY Co. Prentiss

P.O. BOX 42

SHANNON, MISSISSIPPI

(1) Owner of Land:	Description & Color of Materials	Thick-ness Feet	Depth Feet
Wimpany Electric (Name) (Contractor) Bossville, Miss. (Address)	Sand, Clay, Red Clay, Shell, etc. surface sand + clay	0	
(2) Location: 1/4, 1/4, Sec. T 45 R 7 E 6 miles N.W. of Bossville (distance) (direction) (Nearest Town)	Blue rock gravel	20	200
(3) Topography: Hilly (Hilly) (Flat) (Level)	+ Bottom		320
(4) Purpose of Well: Home use (Domestic Irrigation Municipal, Industrial, Other)			


Information upon completion of well:

- (1) Diameter 4 inches.
- (2) Total Depth 320 feet.
- (3) Water Level 60 feet below top of ground.
- (4) Cased to 23' 4", Size 4"
- (5) Screen: Size , Length
- (6) Were any formations sealed against pollution?
 yes, no.

If YES depth of formation 20 ft.

Why Surface + sand

Drillers Remarks:

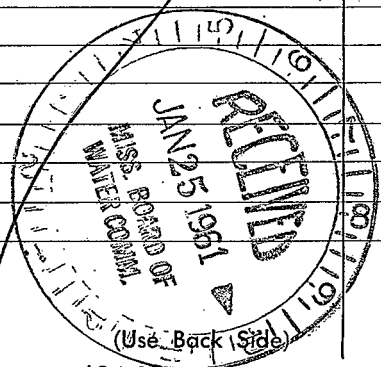

Well No.

