

PRENTISS MISSISSIPPI BOARD OF WATER COMMISSIONERS

B-43

4-62

WATER WELL DRILLERS LOG

Date April, 1962, Driller: HERNDON WELL & SUPPLY CO County Prentiss

P (Name) BOX 42

SHANNON, MISSISSIPPI

(1) Owner of Land: <u>Thrasher School</u> (Name)	Description & Color of Materials Sand, Clay, Red Clay, Shell, etc.	Thick- ness Feet	Depth Feet
<u>Thrasher, Miss</u> (Address)	<u>Red clay</u>		<u>0</u>
(2) Location: <u>23 427 E</u> <u>1/4</u> , <u>1/4</u> , Sec. <u>T 1 R 1 E</u> <u>1</u> miles (distance), of <u>Thrasher</u> (Nearest Town)	<u>Sand</u>		<u>12</u>
(3) Topography: <u>Hilly</u> (Hilly) (Flat) (Level)	<u>Blue silt</u>		<u>47</u>
(4) Purpose of Well: <u>School</u> (Domestic Irrigation Municipal, Industrial, Other)	<u>Sand</u>		<u>87</u>
	<u>Gravel</u>		<u>158</u>
	<u>Sand</u>		<u>172</u>
	<u>Gravel & sand</u>		<u>206</u>
	<u>Rock</u>		<u>285</u>
	<u>Sand</u>		<u>286</u>
	<u>Hard rock</u>		<u>292</u>
	<u>Sand</u>		<u>293</u>
	<u>Rock</u>		<u>418</u>
	<u>Very fine gravel</u>		<u>430</u>
	<u>Gravel 1"</u>		<u>460</u>
	<u>Very hard rock</u>		<u>480</u>

Information upon completion of well:


- (1) Diameter 6" over 4" inches.
- (2) Total Depth 480 feet.
- (3) Water Level 135 feet below top of ground.
- (4) Cased to 423, Size 6"
- (5) Screen: Size 4", Length 20 ft
- (6) Were any formations sealed against pollution?
 yes, no.

If YES depth of formation 418'

Why Sand & sand

Drillers Remarks: Bottom

APP. 80 GPM
5 HP Turbine

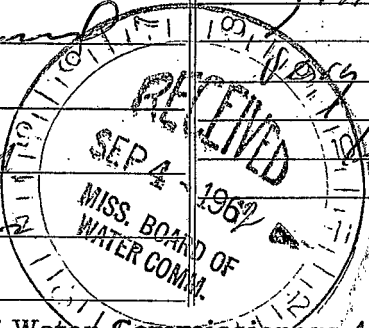

(Use Back Side)

Well No.

(7)

[The body of the document contains extremely faint and illegible text, likely bleed-through from the reverse side of the page. The text is too light to transcribe accurately.]