

B44

3-1-63

WATER WELL DRILLERS LOG

Date: 5/1/63, 1963, Driller: SHANNON WELL & SUPPLY CO., County: Prentiss

P.O. BOX 42 SHANNON, MISSISSIPPI

(1) Owner of Land:	Description & Color of Materials Sand, Clay, Red Clay, Shell, etc.	Thick- ness Feet	Depth Feet
Charles H. Gosses (Name) Brookville, Miss. & Hwy (Address)	Surface & sand		0
(2) Location: 1/4, 1/4, Sec 35 T. 29. E. R. 7. E 3 miles NW, of Brookville (distance) (direction) (Nearest Town)	Blue rock Sand		20 120
(3) Topography: Flat (Hilly) (Flat) (Level)			
(4) Purpose of Well: Domestic (Domestic Irrigation, Municipal, Industrial, Other)	Bottom		242


Information upon completion of well:

- (1) Diameter 4 inches.
- (2) Total Depth 242 feet.
- (3) Water Level _____ feet below top of ground.
- (4) Cased to 31' 9", Size 4"
- (5) Screen: Size _____, Length _____
- (6) Were any formations sealed against pollution?
yes, no.

If YES depth of formation 20'

Why: Surface & sand

Drillers Remarks:

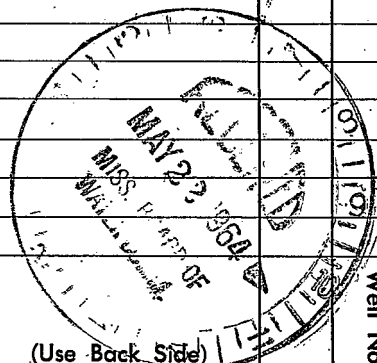

(Use Back Side)

Well No.

