

PRENTISS

B45

4-16-63

WATER WELL DRILLERS LOG

HERNDON WELL & SUPPLY CO.

Date April 16, 1963, Driller: SHANNON P.O. BOX 42 County Prentiss
(Name) (Address) (City) (State)

(1) Owner of Land: M. F. GEND
(Name)
Boonville, Miss
(Address)

(2) Location: 3 1/4 Sec 45 T. 7E R. 7E
4 miles NW, of Boonville
(distance) (direction) (Nearest Town)

(3) Topography: Hilly
(Hilly) (Flat) (Level)

(4) Purpose of Well: Domestic
(Domestic Irrigation)
(Municipal, Industrial, Other)

Description & Color of Materials Sand, Clay, Red Clay, Shell, etc.	Thick- ness Feet	Depth Feet
<u>surface sand</u>		<u>0</u>
<u>& clay</u>		
<u>Blue sand</u>		<u>20</u>
<u>5</u>		
<u>Sand</u>		<u>200</u>
<u>6</u>		
<u>Bottom</u>		<u>300</u>

Information upon completion of well:

(1) Diameter 5 inches.

(2) Total Depth 300 feet.

(3) Water Level 150 feet below top of ground.

(4) Cased to 24', Size 5".


(5) Screen: Size _____, Length _____.

(6) Were any formations sealed against pollution?
 yes, no.

If YES depth of formation 20'.

Why surface sand

Drillers Remarks:

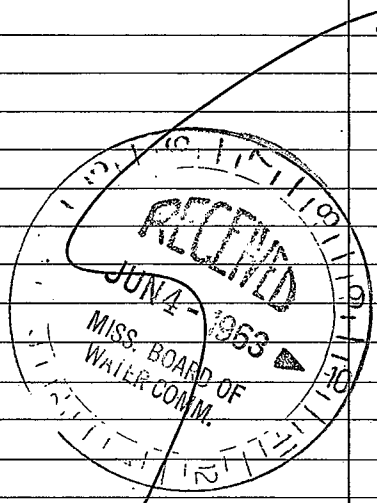

(Use Back Side)

Well No.

