

PRENTISS MISSISSIPPI BOARD OF WATER COMMISSIONERS

B 46  
7-8-64

WATER WELL DRILLERS LOG

Date: 7/8, 1964, Driller: HERNDON WELL & SUPPLY CO. County: Prentiss  
 P. O. BOX 42  
 SHANNON, MISSISSIPPI


(1) Owner of Land: Betty Parks  
 (Name)  
At 3 Piccini, Miss  
 (Address)  
 (2) Location: 1/4, 1/4, Sec 27 T 4S R 1E  
1 miles SW, of Traders  
 (distance) (direction) (Nearest Town)  
 (3) Topography: flat  
 (Hilly) (Flat) (Level)  
 (4) Purpose of Well: Domestic  
 (Domestic Irrigation, Municipal, Industrial, Other)

| Description & Color of Materials<br>Sand, Clay, Red Clay, Shell, etc. | Thick-<br>ness<br>Feet | Depth<br>Feet |
|---|------------------------|---------------|
| <u>surface sand</u>   |                        | <u>0</u>      |
| <u>&amp; clay</u>   |                        |               |
| <u>blue rock</u>  |                        | <u>30</u>     |
| <u>to</u>   |                        |               |
| <u>sand</u>   |                        | <u>70</u>     |
| <u>to</u>   |                        |               |
| <u>bottom</u>   |                        | <u>100</u>    |

Information upon completion of well:

(1) Diameter 4 inches.  
 (2) Total Depth 100 feet.  
 (3) Water Level 40 feet below top of ground.  
 (4) Cased to 9' 4", Size 4".  
 (5) Screen: Size 4", Length 5'.  
 (6) Were any formations sealed against pollution?  
yes, \_\_\_\_\_ no.

If YES depth of formation 30'  
 Why surface sand  
 Drillers Remarks: plaster  
case & screen

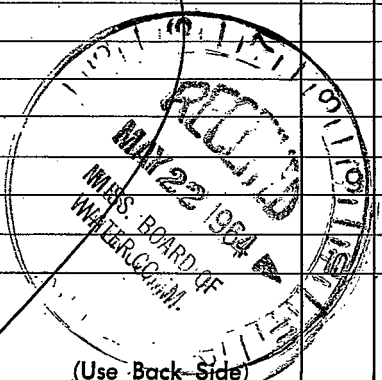

(Use Back-Side)

Well No.

