

MISSISSIPPI BOARD OF WATER COMMISSIONERS

Prentiss  
B48  
9-66

WATER WELL DRILLERS LOG  
BONDS PLUMBING & DRILLING CO.

Date: Sept 7, 1966, Driller: \_\_\_\_\_ County: Prentiss

(Name)

(1) Owner of Land:	Description & Color of Materials Sand, Clay, Red Clay, Shell, etc	Thick- ness Feet	Depth Feet
<u>James Eckford</u> (Name) <u>Booneville Miss</u> (Address)	<u>yellow sand</u> <u>Blue clay</u> <u>white water sand</u>	<u>38</u> <u>37</u> <u>40</u>	<u>110</u>
(2) Location: <u>NE 1/4, 1/4, Sec. T. R.</u> <u>3 miles SW</u> of <u>Piengel</u> (distance) (direction) (Nearest Town)			
(3) Topography: <u>Flat</u> (Hilly) (Flat) (Level)			
(4) Purpose of Well: <u>Domestic</u> (Domestic Irrigation Municipal, Industrial, Other)			


Information upon completion of well:

- (1) Diameter 4 inches.
- (2) Total Depth 110 feet.
- (3) Water Level 25 feet below top of ground.
- (4) Cased to 42, Size 4"
- (5) Screen: Size \_\_\_\_\_, Length \_\_\_\_\_.
- (6) Were any formations sealed against pollution?  
\_\_\_\_\_ yes, \_\_\_\_\_ no.

If YES depth of formation \_\_\_\_\_

Why \_\_\_\_\_

Drillers Remarks: \_\_\_\_\_

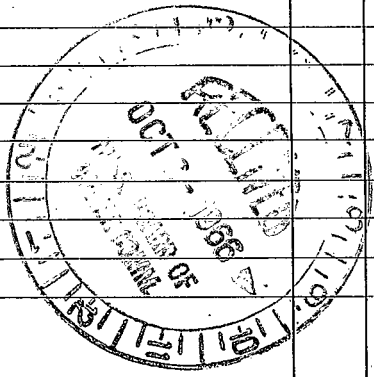

(Use Back Side)

Well No.

