

Prentiss  
B49  
5-67

MISSISSIPPI  
BOARD OF WATER COMMISSIONERS  
416 North State Street  
Jackson, Mississippi 39201

WATER WELL DRILLERS LOG

May 6 1967 date well completed  
Bonds Plumbing & Drilling firm name  
Prentiss county well located

LANDOWNER: Tom DuBoise

description of formations encountered

from to

Route 1  
Boonville Miss  
(mailing address)

Red Clay	0'	9'
Yellow sand	9'	17'
Blue clay	13'	56'
Rock	56'	57 1/2'
Water bearing sand	57 1/2'	76'
Sandy Blue clay	76'	119'
Water Bearing sand	119'	173'

WELL LOCATION:


sec. 22 T 4 N R 7 E  
S W  
1/2 miles W of Thasher  
(distance) (direction) (nearest town)

WELL PURPOSE: Home  
(home, irrigation, municipal, industrial)

WELL COMPLETION DATA:


- diameter (inches) 4 1/2"
- total depth (feet) 173'
- static water level (feet) 20' below top of ground.
- casing BK steel, 34' (material), (depth)  
1 1/2" (size) if telescope see back.
- screen (length) (depth to top)  
10" (size) (material)
- pump 3/4 HP, 6 (yield gpm)  
Elect (type power)
- electric log 10' (yes or no)  
(organization running log)
- how well bottom plugged open

DRILLERS REMARKS:

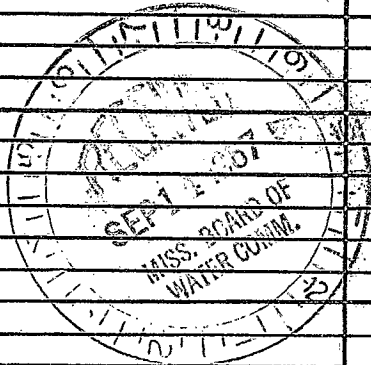

If well telescopes please sketch and show depths.

GROUND LEVEL

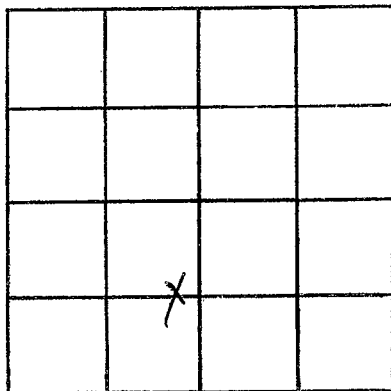

SECTION 22

Please indicate well location X.

ADDITIONAL INFORMATION

If more than one screen, show locations of each on sketch.