

Prentiss  
B50  
7-67

MISSISSIPPI  
BOARD OF WATER COMMISSIONERS  
416 North State Street  
Jackson, Mississippi 39201

WATER WELL DRILLERS LOG

July 28 1967 Bonds Plb. H. Dilling & Prentiss  
date well completed firm name county well located

LANDOWNER: Jack Jumper  
Boonville Miss  
(mailing address)


description of formations encountered	from	to
Sandy Clay	0'	28'
Sandy Blue + Blue Sand	28'	64'
Blue Clay	64'	111'
Water Table	111'	117'

WELL LOCATION:  
sec. 14 E T. 4 N R. 7 E  
7 miles N of Boonville  
(distance) (direction) (nearest town)

WELL PURPOSE: Home  
(home, irrigation, municipal, industrial)

- WELL COMPLETION DATA:
- (1) diameter (inches) 4"
  - (2) total depth (feet) 167'
  - (3) static water level (feet) Not Known above top of ground.
  - (4) casing (material) Bl Steel, (depth) 65'
  - (size) if telescope see back.
  - (5) screen none (length) (depth to top)
  - (size) (material)
  - (6) pump Not Known Set Pumps (HP) (yield gpm)  
Open Pump (type power)
  - (7) electric log No (yes or no)  
(organization running log)
  - (8) how well bottom plugged Open

DRILLERS REMARKS:

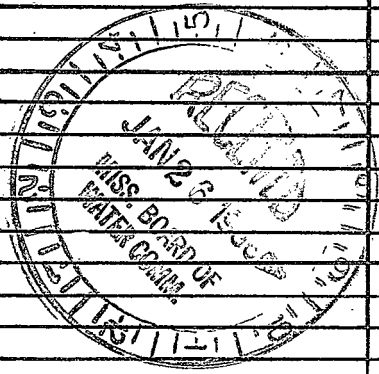

If well telescopes please sketch and show depths.

GROUND LEVEL

X			

SECTION 16

Please indicate well location X.

ADDITIONAL INFORMATION

If more than one screen, show locations of each on sketch.