

PRENTISS
 B51
 2-68
 MISS GEO SUR
 Feb 20 1968

MISSISSIPPI
 BOARD OF WATER COMMISSIONERS
 416 North State Street
 Jackson, Mississippi 39201

WATER WELL DRILLERS LOG

Horndon-Homan Well & Supply, Prentiss
 firm name: Box 42
 SHANNON, MISSISSIPPI 38803 county well located


LANDOWNER: Test Well # 2
 New Candles Water Ass.
 Braxeville, Miss.
 (mailing address)

WELL LOCATION:
 sec 25 T 4 N R 7 E
 3 1/2 miles NE of Braxeville
 (distance) (direction) (nearest town)

WELL PURPOSE: Commercial
 (home, irrigation, municipal, industrial)

WELL COMPLETION DATA:
 (1) diameter (inches) 4
 (2) total depth (feet) 521
 (3) static water level (feet) 208 below top of ground.
 (4) casing steel 400' (material) (depth)
 2" if telescope see back.
 (5) screen 2" other pipe 21" 468' (length) (depth to top)
 2" steel (size) (material)
 (6) pump 2 HP 10 (HP) (yield gpm)
 electric (type power)
 (7) electric log yes (yes or no)
 MISS. Geological Survey (organization running log)
 (8) how well bottom plugged B/W

description of formations encountered	from	to
Red Clay	0	40
Sandy blue clay	40	80
Sand	80	152
Sand w/ shale streak	152	248
Blue clay	248	348
Sand	348	396
Pink quarry clay	396	400
Sand	400	465
Gravel	465	521
Chert	521	521
Bottom	521	521

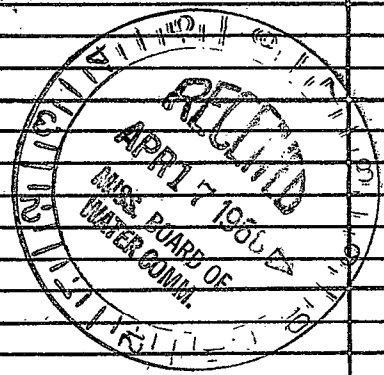

DRILLERS REMARKS:

