

**MISSISSIPPI
BOARD OF WATER COMMISSIONERS**
416 North State Street
Jackson, Mississippi 39201

CODED

WATER WELL DRILLERS LOG

Prentiss
B53
12-73
ELG#65

December 19 73 J. W. Wall & Sons Prentiss
date well completed firm name county well located

LANDOWNER: Thrasher
Water Assoc.
Thrasher, Miss
(mailing address)

description of formations encountered	from	to
<u>Red Clay 2 3' end</u>	<u>0</u>	<u>30</u>
<u>SAND & BLUE ROCK</u>	<u>30</u>	<u>60</u>
<u>BLUE ROCK</u>	<u>60</u>	<u>90</u>
<u>BLUE ROCK & SAND</u>	<u>90</u>	<u>120</u>
<u>SAND</u>	<u>120</u>	<u>240</u>
<u>BLUE ROCK & SAND</u>	<u>240</u>	<u>270</u>
<u>SAND</u>	<u>270</u>	<u>430</u>
<u>SAND & GRAVEL</u>	<u>430</u>	<u>455</u>
<u>GRAVEL</u>	<u>455</u>	<u>485</u>

WELL LOCATION:
sec. 23 T. 4 N. R. 7 E
S NE/4 NE/4 NE/4
miles of (distance) (direction) (nearest town)

WELL PURPOSE: Communit.
(home, irrigation, municipal, industrial)

WELL COMPLETION DATA:

(1) diameter (inches) 10"

(2) total depth (feet) 485'

(3) static water level (feet) 162' below top of ground.

(4) casing STEEL 402'
(material) (depth)
if telescope see back.
(size)

(5) screen 60' 425'
(length) (depth to top)
1" S.S.
(size) (material)

(6) pump 30 250
(HP) (yield gpm)
electric
(type power)

(7) electric log yes USGS
(yes or no)
STATE
(organization running log)

(8) how well bottom plugged

CODED


JAN 21 1974

MISS. BD. OF WATER COM.

DRILLERS REMARKS:

If well telescopes please sketch and show depths.

GROUND LEVEL

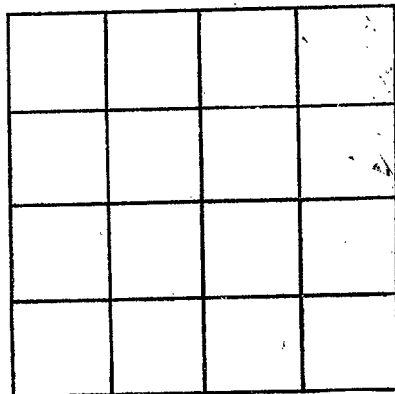

SECTION _____

Please indicate well location X.

ADDITIONAL INFORMATION

If more than one screen, show locations of each on sketch.