

PRENTISS

B57

12/76

E Log # 74

MISSISSIPPI  
 BOARD OF WATER COMMISSIONERS  
 416 North State Street  
 Jackson, Mississippi 39201

WATER WELL DRILLERS LOG


December 19 76 Herndon Well & Supply, Inc. Prentiss  
 date well completed firm name county well located

LANDOWNER:	description of formations encountered	from	to
New Candler Water Assoc., Inc.			
Route 1	Blue Sandy Gumbo	30	90
Booneville, (mailing address)	Blue Sand	90	120
WELL LOCATION:	Snandy Gumbo	120	390
sec. 25 T 45 N R 7 E	Streaked Sand	390	420
x2 east Thrasher	Sand and 8' pea gravel	420	450
1 miles east of Thrasher	Gumbo and Clay	450	475
(distance) (direction) (nearest town)			
WELL PURPOSE: Community			
(home, irrigation, municipal, industrial)			
WELL COMPLETION DATA:			
(1) diameter (inches) 10 x 6			
(2) total depth (feet) 420			
(3) static water level (feet) 195 below top of ground.			
(4) casing Steel 342 (material) (depth)			
10 if telescope see back. (size)			
(5) screen 60' 360 (length) (depth to top)			
8" Stainless Steel (size) (material)			
(6) pump 30 197 (HP) (yield gpm)			
Elec. (type power)			
(7) electric log USGS (yes or no) USGS (organization running log)			
(8) how well bottom plugged BWV 6"			
DRILLERS REMARKS:			

RECEIVED  
 DEC 23 1976

MISS. BD. OF WATER COMMISSIONERS

If well telescopes please sketch and show depths.

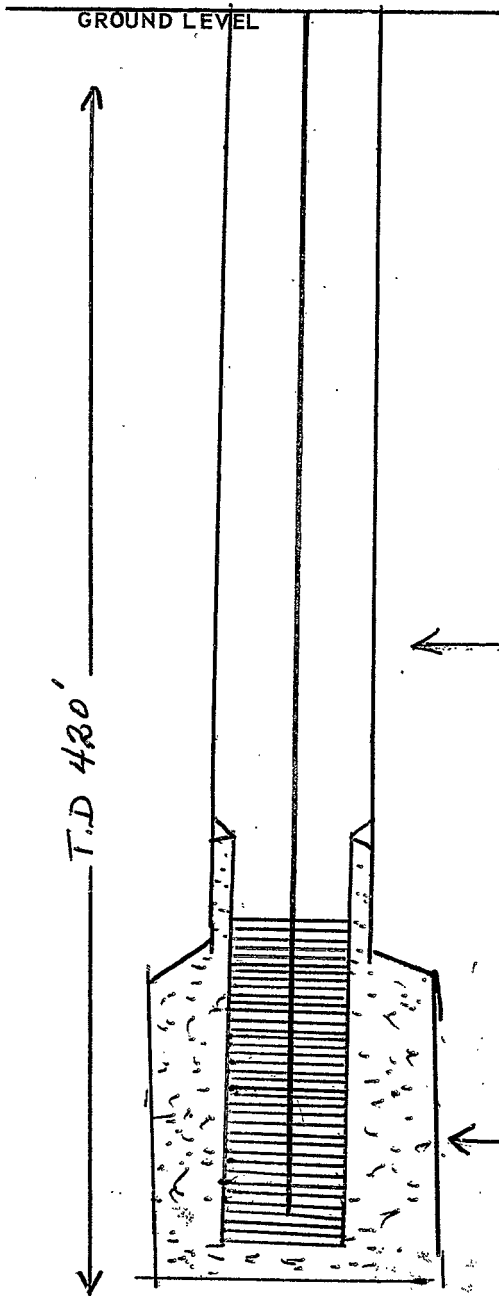

If more than one screen, show locations of each on sketch.

		X	

SECTION 25

Please indicate well location X.

ADDITIONAL INFORMATION

342' 10"

11 CU YD GRAVEL