

MISSISSIPPI DEPARTMENT OF NATURAL RESOURCES

Bureau of Land and Water Resources

Southport Mall

P.O. Box 10631

Jackson, Mississippi 39209

WATER WELL DRILLERS LOG

PRENTISS
B59
1/90

JAN

1990 J.W. WEBB & SONS

PRENTISS

date well completed

firm name

county well located

LANDOWNER: THRASHER
WATER ASSOC.
THRASHER, MISS
(mailing address)

description of formations encountered

from

to

RED CLAY	0	30
BLUE SANDY CLAY	30	120
SAND & ROCK	120	300
SANDY CLAY	300	420
GRAVEL	420	480
ROCK	480	495

WELL LOCATION:

sec. 23 T 4 S R 7 E
1/2 miles WEST of THRASHER
(distance) (direction) (nearest town)

WELL PURPOSE: MUNICIPAL
(home, irrigation, municipal, industrial)

WELL COMPLETION DATA:

- (1) diameter (inches) 10"
- (2) total depth (feet) 483
- (3) static water level (feet) 190 below top of ground.
- (4) casing STEEL 412
(material) (depth)
- (size) if telescope see back.
- (5) screen 50' 430'
(length) (depth to top)
- (size) (material)
6 S.S.
- (6) pump 30 200
(HP) (yield gpm)
- ELECTRIC
(type power)
- (7) electric log YES
(yes or no)
- STATE
(organization running log)

(8) how well bottom plugged
BACK-WASH VALVE

DRILLERS REMARKS:


RECEIVED

FEB 04 1991

Dept. of Environmental Quality
Bureau of Land & Water Resources

If well telescopes please
sketch and show depths.

GROUND LEVEL

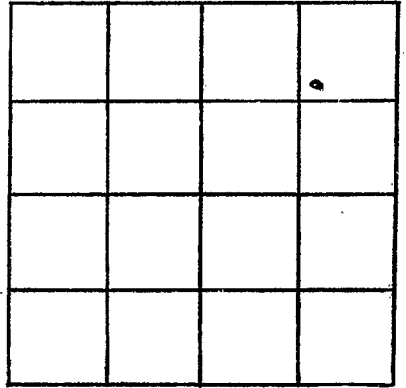

SECTION 23

Please indicate well location X.

ADDITIONAL INFORMATION

If more than one screen,
show locations of each on sketch.