

MISSISSIPPI DEPARTMENT OF ENVIRONMENTAL QUALITY
Office of Land and Water Resources

P. O. Box 10631
Jackson, MS 39289-0631
WATER WELL DRILLERS LOG

117

COUNTY WELL LOCATED
PRENTISS

WELL NUMBER
13-64

CODED

DATE WELL COMPLETED
9-21-04

PERMIT NUMBER

NAME OF DRILLING FIRM
PARKS + PARKS WELL SERVICE

HOUSTON MS 38857

NAME & MAILING ADDRESS OF LANDOWNER **WELL # 1**
BOONVILLE COUNTRY CLUB

Latitude:
Longitude:

WELL LOCATION: SEC **29** TOWNSHIP **4 N** RANGE **7 E**

DISTANCE **2** Miles DIRECTION **NORTH** of NEAREST TOWN **BOONVILLE**

OTHER LANDMARK

WELL PURPOSE: Home, Irrigation, Municipal, Industrial, Fish Pond, etc.

PUMP DATA

PUMP TYPE (Circle One):
Submersible, Turbine, Jet, Flowing Well,
Other (Describe) _____

POWER TYPE (Circle One):
Electric, Tractor, Diesel, Gasoline, Butane,
Other (Describe) _____ H/P **5**

DESCRIPTION OF FORMATIONS ENCOUNTERED	FROM	TO
CLAY	0	60
SAND + CLAY	60	80
CLAY	80	120
SAND	120	130
SAND + CLAY	130	160
SAND	160	210
CLAY	210	220

WELL DATA

Well Depth 210	Casing Diameter (In.) 4	Casing Length (Ft.) 150
Type of Casing PVC	Hole Depth 220	Depth to Static Water Level

TYPE OF COMPLETION: (Circle One or More):
Gravel Packed, Underreamed, Telescoped,
Natural Development, Open Hole, Other

WELL GROUTED TO A DEPTH OF **20** FEET
Type Grout (circle one): Cement, Bentonite, or Mix

SCREEN DATA

Diameter - Inches 4	Length - Feet 60	Slot Size - Inches .010
Screen Type PVC	Depth to Bottom - Feet 210	

RECEIVED
OCT 13 2004
BY: OLWR

Top of Lap Pipe or Reduction in Casing

FEET IF TELESCOPED OR MORE THAN ONE SCREEN: USE BACK PAGE


I certify that the well was drilled, constructed and completed in accordance with all applicable Requirements of the Mississippi Department of Environmental Quality and/or the Mississippi Department of Health regulations and state laws.

Ryan Smith 0414
Signature of Licensed Driller and License No.

10/2/04
Date

Additional Information Required On Back

If well telescopes please sketch and show depths.

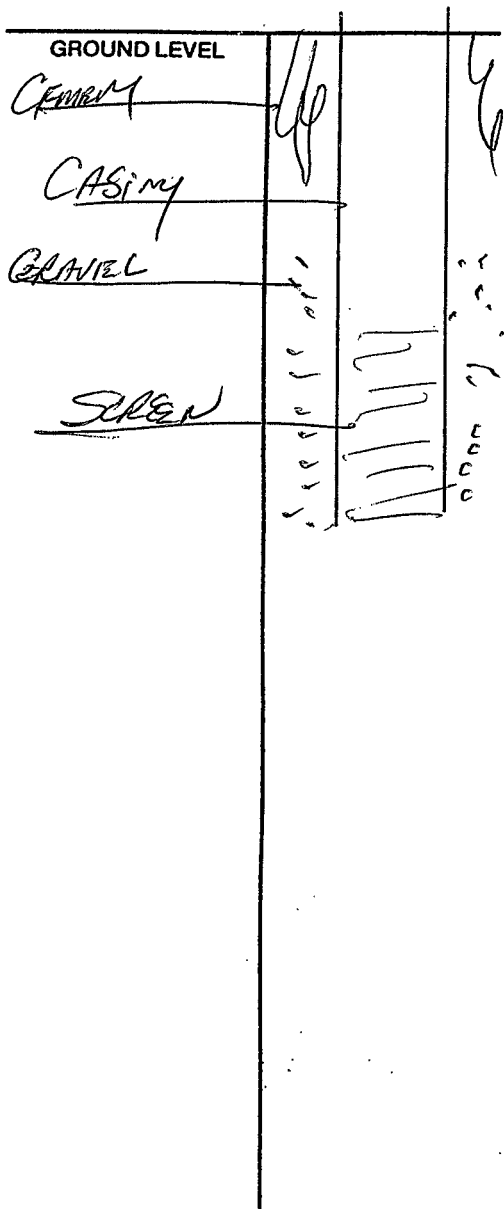

SECTION _____

Please indicate well location X.

Pump Capacity (GPM)	No. of Stages	Setting Depth	FT.
50	13	189	

PUMP TEST

Well yielded _____ GPM with
 a drawdown of _____ ft.
 after _____ hours of pumping

LOG DATA

TYPE OF LOG RUN (Circle One): No Log Run
 Electric, Gamma Ray, Density, Sonic, Neutron,
 Other (Describe) _____

Name of Organization Running Log _____

GEOLOGIC DATA (Office Use Only)

Surface Elev.	Geologic Unit	Unit Thickness	Depth to Top
Subs. SWL	Date	Analysis	Aquifer Test

Driller's Remarks

If more than one screen,
 show location of each on sketch.