

MISSISSIPPI DEPARTMENT OF ENVIRONMENTAL QUALITY

Office of Land and Water Resources

P. O. Box 10631
Jackson, MS 39289-0631

WATER WELL DRILLERS LOG

117

COUNTY WELL LOCATED
PIANTISS

WELL NUMBER
B-66

CODED

DATE WELL COMPLETED
9-16-04

PERMIT NUMBER

NAME OF DRILLING FIRM
PARRS + PARRS WELL SERVICE

HOUSTON MS

NAME & MAILING ADDRESS OF LANDOWNER Well # 3
BROOKVILLE COUNTRY CLUB

BROOKVILLE MS.

Latitude:

Longitude:

WELL LOCATION: SEC 29 TOWNSHIP 4 N RANGE 7 E

DISTANCE 2 Miles DIRECTION NORTH of NEAREST TOWN BROOKVILLE

OTHER LANDMARK

WELL PURPOSE: Home, Irrigation, Municipal, Industrial, Fish Pond, etc.

PUMP DATA

PUMP TYPE (Circle One):
Submersible, Turbine, Jet, Flowing Well,
Other (Describe)

POWER TYPE (Circle One):
Electric, Tractor, Diesel, Gasoline, Butane,
Other (Describe) H/P 5

DESCRIPTION OF FORMATIONS ENCOUNTERED	FROM	TO
<u>CLAY</u>	<u>0</u>	<u>60</u>
<u>SAND + CLAY</u>	<u>100</u>	<u>80</u>
<u>CLAY</u>	<u>80</u>	<u>120</u>
<u>SAND</u>	<u>120</u>	<u>130</u>
<u>SAND + CLAY</u>	<u>130</u>	<u>160</u>
<u>SAND</u>	<u>160</u>	<u>210</u>
<u>CLAY</u>	<u>210</u>	<u>220</u>

WELL DATA

Well Depth 210 Casing Diameter (In.) 4 Casing Length (Ft.) 150

Type of Casing PVC Hole Depth 220 Depth to Static Water Level

TYPE OF COMPLETION: (Circle One or More):
Gravel Packed, Underreamed, Telescoped,
Natural Development, Open Hole, Other
(Describe)

WELL GROUTED TO A DEPTH OF 20 FEET
Type Grout (circle one): Cement, Bentonite, or Mix

SCREEN DATA

Diameter - Inches 4 Length - Feet 60 Slot Size - Inches .010

Screen Type PVC Depth to Bottom - Feet 210

RECEIVED

OCT 13 2004

BY: OLWR

Top of Lap Pipe or Reduction in Casing

FEET IF TELESCOPED OR MORE THAN ONE SCREEN: USE BACK PAGE


I certify that the well was drilled, constructed and completed in accordance with all applicable Requirements of the Mississippi Department of Environmental Quality and/or the Mississippi Department of Health regulations and state laws.

[Signature] 0-414
Signature of Licensed Driller and License No.

10/12/04
Date

Additional Information Required On Back

If well telescopes please sketch and show depths.

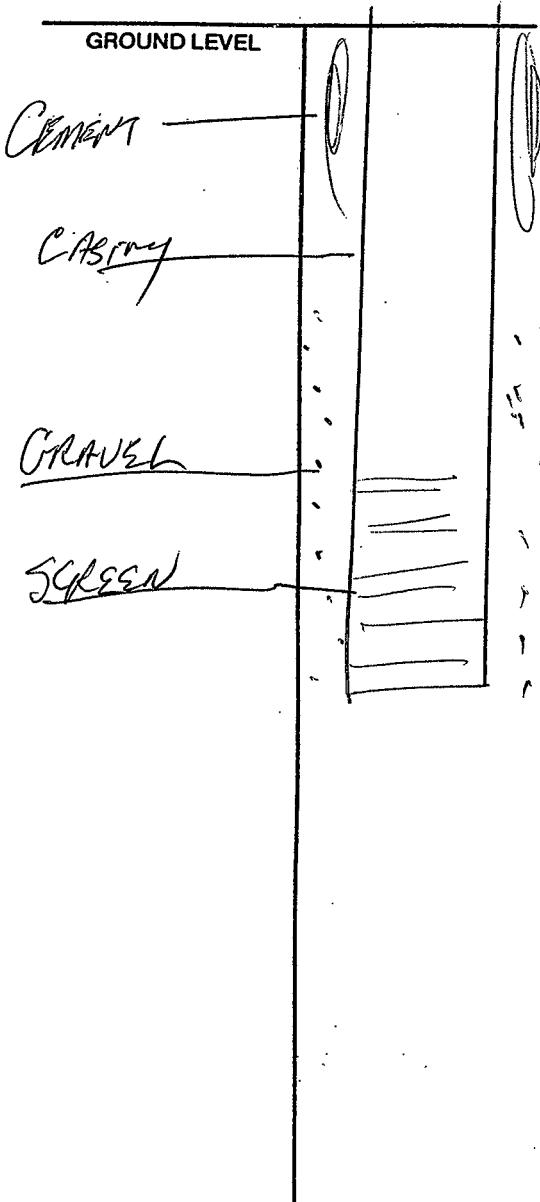

SECTION _____

Please indicate well location X.

Pump Capacity (GPM)	No. of Stages	Setting Depth	
50	13	189	FT.
PUMP TEST			
Well yielded _____ GPM with			
a drawdown of _____ ft.			
after _____ hours of pumping			

LOG DATA

TYPE OF LOG RUN (Circle One): No Log Run, Electric, Gamma Ray, Density, Sonic, Neutron, Other (Describe) _____

Name of Organization Running Log _____

GEOLOGIC DATA (Office Use Only)

Surface Elev.	Geologic Unit	Unit Thickness	Depth to Top
Subs. SWL	Date	Analysis	Aquifer Test

Driller's Remarks

If more than one screen, show location of each on sketch.