

PRENTISS

B 2000

8-2-78

MISSISSIPPI BOARD OF WATER COMMISSIONERS
416 North State Street
Jackson, Mississippi 39201

WATER WELL DRILLERS LOG

8-2 1978 BombWell Drilling Prentiss
date well completed firm name county well located

LANDOWNER: Robinson

Booneville

(mailing address)

WELL LOCATION:

sec. 10 T 4 N R 7 E
6 miles N of Booneville
(distance) (direction) (nearest town)

WELL PURPOSE: Home
(home, irrigation, municipal, industrial)

WELL COMPLETION DATA:

- (1) diameter (inches) 4"
- (2) total depth (feet) 140
- (3) static water level (feet) 60 below above top of ground.
- (4) casing Plastic 60
(material) (depth)
- (size) If telescope see back.
- (5) screen no
(length) (depth to top)
- (size) (material)
- (6) pump 1 1/2 5 gpm
(HP) (yield gpm)
- elect
(type power)
- (7) electric log no
(yes or no)
- (organization running log)
- (8) how well bottom plugged open

description of formations encountered

from	to
0	10
10	55
55	80
80	140

Red Clay
Yellow Sand
Blue Clay
Water Sand


DRILLERS REMARKS:

RECEIVED
DEC-5 1978

MISS. BD. OF WATER COMM

If well telescopes please sketch and show depths.

GROUND LEVEL

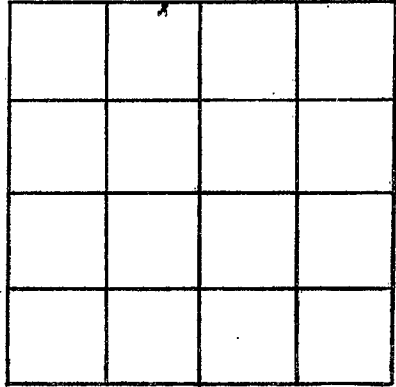

SECTION _____

Please indicate well location X.

ADDITIONAL INFORMATION

If more than one screen, show locations of each on sketch.