

PRENTISS  
C11  
12-67  
Miss Geo SUR

MISSISSIPPI  
BOARD OF WATER COMMISSIONERS  
416 North State Street  
Jackson, Mississippi 39201

WATER WELL DRILLERS LOG

date well completed: 12/23/29 Merndon-Homan Well & Supply, Inc. Prentiss  
firm name Box 42 county well located  
SHANNON, MISSISSIPPI 38668

LANDOWNER: Test Well #1  
New Canfield Water Ass.  
Boonville, Miss  
(mailing address)


description of formations encountered	from	to
Red clay	0	28
Sandy blue clay	28	70
Sand	70	132
Sandy blue clay	132	310
Shale	310	396
Sand w/ shale streaks	396	428
Gravel	428	450
Pink sunny clay	450	454
Chert	454	500
Rockes	500	527
Bottom	527	

WELL LOCATION:  
sec. 20 T 4 N R 8 E  
S W  
4 1/2 miles NE of Boonville  
(distance) (direction) (nearest town)

WELL PURPOSE: commercial  
(home, irrigation, municipal, industrial)

WELL COMPLETION DATA:

- (1) diameter (inches) 4
- (2) total depth (feet) 527
- (3) static water level (feet) 185 below top of ground.
- (4) casing Steel, 428' (material) (depth)  
2 if telescope see back.  
(size)
- (5) screen 21' 428' (length) (depth to top)  
2" steel (size) (material)
- (6) pump 1/2 (HP) 10 (yield gpm)  
electric (type power)
- (7) electric log yes (yds or no)  
Miss. Geological Survey (organization running log)
- (8) how well bottom plugged B/W

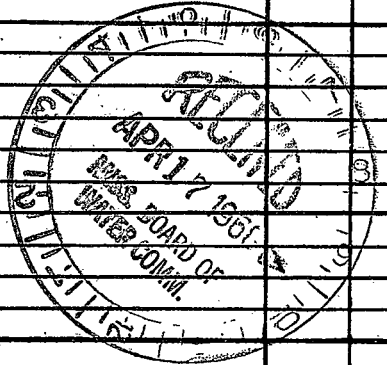

DRILLERS REMARKS:

If well telescopes please sketch and show depths.

GROUND LEVEL



4" CASING  
428'

~~Lead Seal~~

Black 24'  
4.25"

2" pipe  
2" pipe

Black  
84'

527'

X			

SECTION 20

Please indicate well location X.

ADDITIONAL INFORMATION

If more than one screen, show locations of each on sketch.