

Prentiss
C 13
4-28-70

MISSISSIPPI
BOARD OF WATER COMMISSIONERS
416 North State Street
Jackson, Mississippi 39201

WATER WELL DRILLERS LOG

4-28 1970 Bond Well Drilling Prentiss
date well completed firm name county well located

LANDOWNER: Freeman Peppers
Brommwell
(mailing address)

| description of formations encountered | depth | |
|---------------------------------------|-------|-----|
| | from | to |
| Red sand | 0 | 40 |
| Blue clay | 40 | 112 |
| Water sand | 112 | 152 |

WELL LOCATION:
sec 29 T 4 N R 8 E
12 miles East of Brommwell
(distance) (direction) (nearest town)

WELL PURPOSE: Home
(home, irrigation, municipal, industrial)


- WELL COMPLETION DATA:
- (1) diameter (inches) 4
 - (2) total depth (feet) 152
 - (3) static water level (feet) 63 below top of ground.
 - (4) casing steel 45 (material) (depth)
 - (size) if telescope see back.
 - (5) screen none (length) (depth to top)
 - (size) (material)
 - (6) pump (HP) (yield gpm)
Horse on pump (type power)
 - (7) electric log no (yes or no)
 - (organization running log)
 - (8) how well bottom plugged open

MAY 4 1970

DRILLERS REMARKS:

If well telescopes please sketch and show depths.

GROUND LEVEL

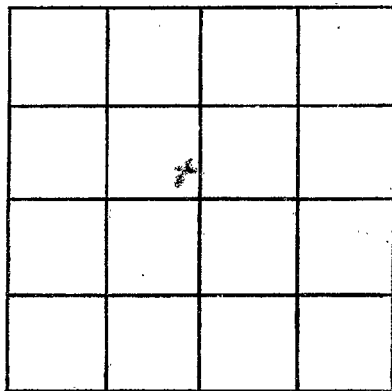

SECTION _____

Please indicate well location X.

ADDITIONAL INFORMATION

If more than one screen,
show locations of each on sketch.