

PRENTISS

C 14

3-8-71

MISSISSIPPI BOARD OF WATER COMMISSIONERS
416 North State Street
Jackson, Mississippi 39201

CODED

WATER WELL DRILLERS LOG

3-8

1971

Bond Well Drilling

Prentiss

date well completed

firm name

county well located

LANDOWNER:

James Morgan

description of formations encountered

from

to

Boonville Miss
(mailing address)

Red sand
Blue clay
Water sand

0 17
17 119
119 160

WELL LOCATION:

sec. 34 T-4 N R-8 E

12 miles East of Boonville
(distance) (direction) (nearest town)

WELL PURPOSE:

Water
(home, irrigation, municipal, industrial)

WELL COMPLETION DATA:

- (1) diameter (inches) 4
- (2) total depth (feet) 160
- (3) static water level (feet) 30 below above top of ground.
- (4) casing Steel 21 (material) (depth)

CODED

(size) If telescope see back.

- (5) screen None (length) (depth to top)

(size) (material)

- (6) pump Had on pump (HP) (yield, gpm)
(type power)

- (7) electric log No (yes or no)

(organization running log)

- (8) how well bottom plugged Open


APR 6 1971

DRILLERS REMARKS:

MISSISSIPPI BOARD OF WATER COMMISSIONERS

If well telescopes please sketch and show depths.

GROUND LEVEL

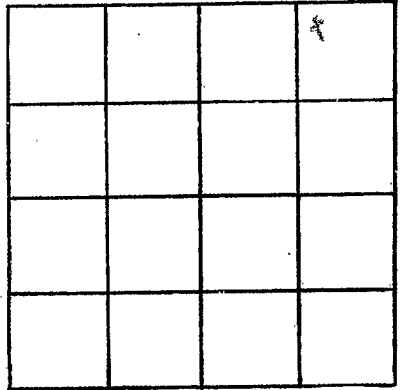

SECTION _____

Please indicate well location X.

ADDITIONAL INFORMATION

If more than one screen,
show locations of each on sketch.