

**Prentiss**  
**C17**  
**11-4-71**

MISSISSIPPI  
 BOARD OF WATER COMMISSIONERS DEC 9 1971  
 416 North State Street  
 Jackson, Mississippi 39201

WATER WELL DRILLERS LOG **CODED**

**11-4-** date well completed **1971** **Borden Well Drilling Prentiss** firm name **Prentiss** county well located

LANDOWNER: **Jimmy Mc Card**

**Brownell Miss**  
 (mailing address)

description of formations encountered	from	to
<b>Red clay</b>	<b>0</b>	<b>52</b>
<b>blue sand</b>	<b>52</b>	<b>105</b>
<b>water sand</b>	<b>105</b>	<b>147</b>

WELL LOCATION:  
 sec **7** T **4** N R **8** E  
 S W  
**6** miles **N-E** of **Brownell**  
 (distance) (direction) (nearest town)

WELL PURPOSE: **Home**  
 (home, irrigation, municipal, industrial)


- WELL COMPLETION DATA:
- (1) diameter (inches) **4**
  - (2) total depth (feet) **147**
  - (3) static water level (feet) **60** below above top of ground.
  - (4) casing **Steel**, **147**  
 (material) (depth)  
 (size) if telescope see back.
  - (5) screen **perforated Castin**  
 (length) (depth to top)  
 (size) (material)
  - (6) pump **34** **6**  
 (HP) (yield gpm)  
**Clear Hand**  
 (type power)
  - (7) electric log **no**  
 (yes or no)  
 (organization running log)
  - (8) how well bottom plugged **plug**

**CODED**

DRILLERS REMARKS:

If well telescopes please sketch and show depths.

GROUND LEVEL

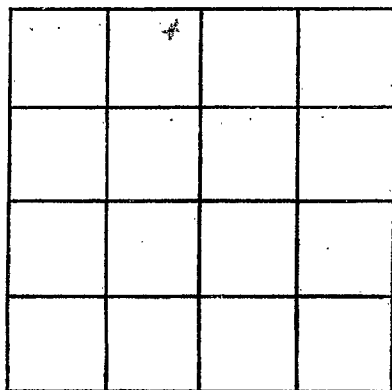

SECTION \_\_\_\_\_

Please indicate well location X.

ADDITIONAL INFORMATION

A series of horizontal lines providing space for additional information.

If more than one screen, show locations of each on sketch.