

PRENTISS

C18

8-4-72

MISSISSIPPI BOARD OF WATER COMMISSIONERS 416 North State Street Jackson, Mississippi 39201

CODED

WATER WELL DRILLERS LOG

8-4 date well completed

1972 Bonds Well Drilling firm name

Prentiss county well located

LANDOWNER: Jim Burcham

description of formations encountered

from to

Bonnville (mailing address)

Red Clay 0 19 Blue Clay 19 155 Water Sand 155 200

WELL LOCATION:

sec. 27 T. 4 N R. 8 E 10 miles East of Bonnville (distance) (direction) (nearest town)

WELL PURPOSE: Home (home, irrigation, municipal, industrial)

WELL COMPLETION DATA:

- (1) diameter (inches) 4
(2) total depth (feet) 200
(3) static water level (feet) 18 below top of ground.
(4) casing 2 1/2 (material) 21 (depth)
(5) screen none (length) (depth to top)
(6) pump 3/4 (HP) 5 (yield gpm)
(7) electric log no (yes or no)
(8) how well bottom plugged open

CODED


SEP 11 1972

DRILLERS REMARKS:

MISS. DD. OF WATER COMMISSIONERS

If well telescopes please sketch and show depths.

GROUND LEVEL

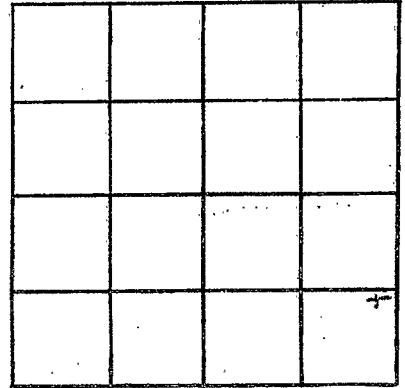

SECTION \_\_\_\_\_

Please indicate well location X.

ADDITIONAL INFORMATION

If more than one screen,  
show locations of each on sketch.