

Prentiss
C 23
3-13-74

MISSISSIPPI
BOARD OF WATER COMMISSIONERS
416 North State Street
Jackson, Mississippi 39201

CODED

WATER WELL DRILLERS LOG

3-13-1974 Bondwell Drilling Prentiss
date well completed firm name county well located

LANDOWNER: <u>Nolen Newborn</u> <u>Boneville, Miss</u>	description of formations encountered	from	to
(mailing address)	<u>Red clay</u> <u>Blue clay</u> <u>Water Sand</u>	<u>0</u> <u>30</u> <u>165</u>	<u>30</u> <u>16.5</u> <u>195</u>
WELL LOCATION: sec. <u>27</u> T. <u>4</u> N. R. <u>8</u> E. <u>10</u> miles <u>East</u> of <u>Boneville</u> (distance) (direction) (nearest town)			
WELL PURPOSE: <u>Home</u> (home, irrigation, municipal, industrial)			
WELL COMPLETION DATA:			
(1) diameter (inches) <u>4"</u>			
(2) total depth (feet) <u>195</u>			
(3) static water level (feet) <u>70</u> ^{below} _{above} top of ground.			
(4) casing <u>Steel</u> , <u>42</u> , (material) (depth)			
(size) if telescope see back.			
(5) screen <u>None</u> (length) (depth to top)			
(size) (material)			
(6) pump <u>3/4</u> <u>5</u> (HP) (yield gpm)			
<u>Jep</u> (type power)			
(7) electric log <u>no</u> (yes or no)			
(organization running log)			
(8) how well bottom plugged <u>open</u>			
DRILLERS REMARKS:			


CODED

RECORDED

JUN 26 1974

If well telescopes please sketch and show depths.

GROUND LEVEL

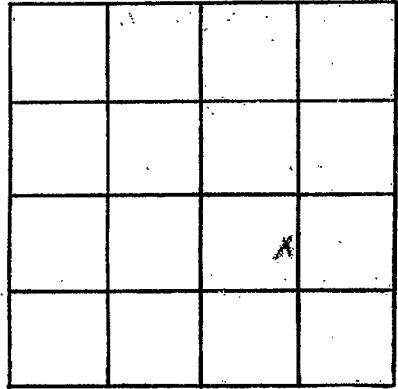

SECTION _____

Please indicate well location X.

ADDITIONAL INFORMATION

If more than one screen, show locations of each on sketch.