

Prentiss
C 24
7-15-74

MISSISSIPPI
BOARD OF WATER COMMISSIONERS
416 North State Street
Jackson, Mississippi 39201

CODED

WATER WELL DRILLERS LOG

7-15 date well completed
1974 Bonds Well Drilling firm name
Prentiss county well located


LANDOWNER: <u>Senoard Hitchcock</u>	description of formations encountered	from	to
<u>Boonville, Miss.</u> (mailing address)			
	Red clay	0	38
	Blue clay	38	192
	Water Sand	192	235
WELL LOCATION:			
sec <u>23</u> T <u>4</u> N R <u>2</u> E			
<div style="display: flex; justify-content: space-around;"> (distance) <u>10</u> miles (direction) <u>E</u> (nearest town) <u>Boonville</u> </div>			
WELL PURPOSE: <u>Home</u> (home, irrigation, municipal, industrial)			
WELL COMPLETION DATA:			
(1) diameter (inches) <u>4"</u>			
(2) total depth (feet) <u>235'</u>			
(3) static water level (feet) <u>80</u> ^{below} _{above} top of ground.			
(4) casing <u>Steel</u> , <u>42'</u> (material) (depth)			
<u>None</u> if telescope see back. (size)			
(5) screen <u>None</u> (length) (depth to top)			
(size) (material)			
(6) pump <u>3/4</u> <u>10</u> (HP) (yield gpm)			
<u>Sub</u> (type power)			
(7) electric log <u>NO</u> (yes or no)			
(organization running log)			
(8) how well bottom plugged <u>open</u>			
DRILLERS REMARKS:			

RECEIVED
OCT - 1 1974

MISS. BD. OF WATER COMM

If well telescopes please sketch and show depths.

GROUND LEVEL

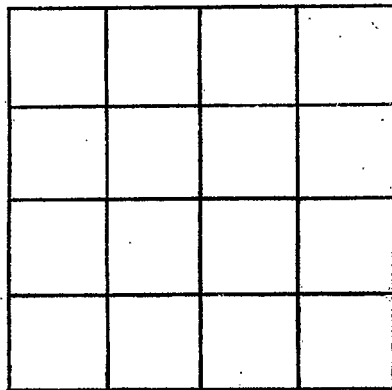

SECTION _____

Please indicate well location X.

ADDITIONAL INFORMATION

If more than one screen, show locations of each on sketch.