

PRENTISS

C 8525

10-31-74

MISSISSIPPI BOARD OF WATER COMMISSIONERS  
416 North State Street  
Jackson, Mississippi 39201

CODED

WATER WELL DRILLERS LOG

10-31  
date well completed

1974 Bonds well Drilling  
firm name

Prentiss  
county well located

LANDOWNER: Joe McCarter

Bonneville,  
Miss.

(mailing address)

description of formations encountered

from

to

Red clay  
Blue clay  
Water sand

0 13  
13 290  
290 340

WELL LOCATION:

sec. 17 T 4 N R 8 E 16L  
8 miles S N of Bonneville  
(distance) (direction) (nearest town)

WELL PURPOSE: Home  
(home, irrigation, municipal, industrial)

WELL COMPLETION DATA:

CODED

- (1) diameter (inches) 4"
- (2) total depth (feet) 340
- (3) static water level (feet) 120 below top of ground.

- (4) casing Steel, 17 (depth)  
(material) (depth)  
(size) If telescope see back.

- (5) screen None  
(length) (depth to top)

- (6) pump 3/4 10  
(HP) (yield gpm)

Sub  
(type power)

- (7) electric log NO  
(yes or no)

(organization running log)


- (8) how well bottom plugged open

DRILLERS REMARKS:

MAR 18 1975

If well telescopes please sketch and show depths.

GROUND LEVEL

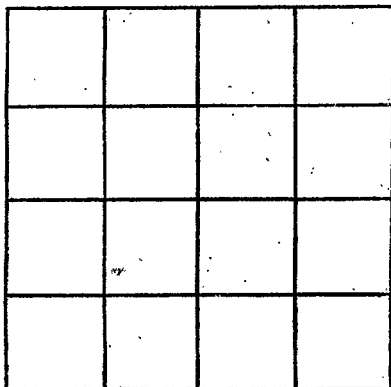

SECTION \_\_\_\_\_

Please indicate well location X.

ADDITIONAL INFORMATION

If more than one screen, show locations of each on sketch.