

Prentiss
C 26
9-16-75

MISSISSIPPI
 BOARD OF WATER COMMISSIONERS **CODED**
 416 North State Street
 Jackson, Mississippi 39201

WATER WELL DRILLERS LOG

9-16 1975 Bondwell Drilling Prentiss
 date well completed firm name county well located

LANDOWNER Bobby Hutchens
Booneville, Miss.
 (mailing address)

| description of formations encountered | from | to |
|---------------------------------------|------------|------------|
| <u>Red clay</u> | <u>0</u> | <u>32</u> |
| <u>Yellow sand</u> | <u>32</u> | <u>88</u> |
| <u>Blue clay</u> | <u>88</u> | <u>275</u> |
| <u>Water sand</u> | <u>275</u> | <u>320</u> |

WELL LOCATION:
 sec 27 T 4 N R 8 E ^{13B}
12 miles NE of Boo
 (distance) (direction) (nearest town)

WELL PURPOSE: Home
 (home, irrigation, municipal, industrial)

WELL COMPLETION DATA:

(1) diameter (inches) 4"

(2) total depth (feet) 320'

(3) static water level (feet) 160 ^{below} _{above} top of ground.

(4) casing Steel, 105'
 (material) (depth)

_____ If telescope see back.
 (size)

(5) screen NO
 (length) (depth to top)

_____ (size) _____ (material)

(6) pump 3/4 10
 (HP) (yield gpm)

Electric
 (type power)

(7) electric log NO
 (yes or no)

_____ (organization running log)

(8) how well bottom plugged Open


DRILLERS REMARKS: _____

CODED

RECEIVED
 SEP 21 1975

If well telescopes please sketch and show depths.

GROUND LEVEL

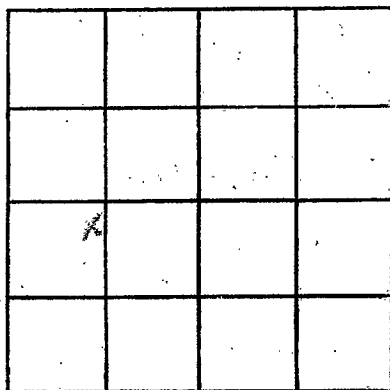

SECTION _____

Please indicate well location X.

ADDITIONAL INFORMATION

If more than one screen, show locations of each on sketch.