

Prentiss  
C 27  
5-23-75

MISSISSIPPI  
 BOARD OF WATER COMMISSIONERS  
 416 North State Street  
 Jackson, Mississippi 39201

CODED

WATER WELL DRILLERS LOG

5-23

date well completed

1975 Bonds Well Drilling

firm name

Prentiss

county well located


LANDOWNER: <u>Jimmy Hutcherson</u> <u>Bonneville, Miss.</u>	description of formations encountered	from	to
(mailing address)	<u>Red clay</u>	<u>0</u>	<u>32</u>
WELL LOCATION: sec. <u>27</u> T. <u>4</u> N. R. <u>8</u> <u>E</u> <sup>136</sup> <u>12</u> miles <u>NE</u> of <u>Boo.</u> (distance) (direction) (nearest town)	<u>Yellow sand</u>	<u>32</u>	<u>88</u>
WELL PURPOSE: <u>Home</u> (home, irrigation, municipal, industrial)	<u>Blue clay</u>	<u>88</u>	<u>255</u>
WELL COMPLETION DATA: (1) diameter (inches) <u>4"</u> (2) total depth (feet) <u>300'</u> (3) static water level (feet) <u>160</u> <sup>below</sup> <sub>above</sub> top of ground. (4) casing <u>Steel</u> , <u>10.5'</u> (material) (depth) ____ (size) if telescope see back. (5) screen <u>None</u> (length) (depth to top) ____ (size) (material) (6) pump <u>3/4</u> <u>10</u> (HP) (yield gpm) <u>Elect.</u> (type power) (7) electric log <u>NO</u> (yes or no) ____ (organization running log) (8) how well bottom plugged <u>open</u>	<u>Water sand</u>	<u>255</u>	<u>310</u>
DRILLERS REMARKS:			

CODED

RECEIVED  
 MISS. BO. OF WATER COMM.  
 JUN 21 1975  
 JUN 22 1975

If well telescopes please sketch and show depths.

GROUND LEVEL

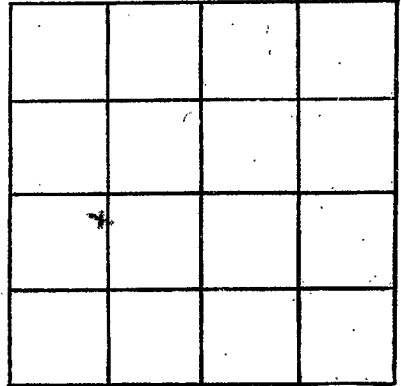

SECTION \_\_\_\_\_

Please indicate well location 'X'.

ADDITIONAL INFORMATION

If more than one screen, show locations of each on sketch.