

PRENTISS
 C 2002
 3/68

MISSISSIPPI
 BOARD OF WATER COMMISSIONERS
 416 North State Street
 Jackson, Mississippi 39201

WATER WELL DRILLERS LOG

Marks 19 18 Bonds Plumbing & Drilling Co Prentiss
 date well completed firm name county well located


LANDOWNER: Le Bain
Route 6
Booneville Miss
 (mailing address)

description of formations encountered	from	to
<u>Sandy Clay</u>	<u>0</u>	<u>38</u>
<u>Blue "f"</u>	<u>38</u>	<u>140</u>
<u>Shale Sand</u>	<u>140</u>	<u>200</u>

WELL LOCATION:
 sec 34 T 4 N R 8 E
9 miles E of Booneville
 (distance) (direction) (nearest town)

WELL PURPOSE: Home
 (home, irrigation, municipal, industrial)


- WELL COMPLETION DATA:
- (1) diameter (inches) 4"
 - (2) total depth (feet) 200
 - (3) static water level (feet) 56 below top of ground.
 - (4) casing Steel, 42,
 (material) (depth)
~~4"~~ (size) telescope see back.
 - (5) screen none,
 (length) (depth to top)
none
 (size) (material)
 - (6) pump 1/2 HP 1/2
 (type power) (yield gpm)
 - (7) electric log none
 (yes or no)
none
 (organization running log)
 - (8) how well bottom plugged Open

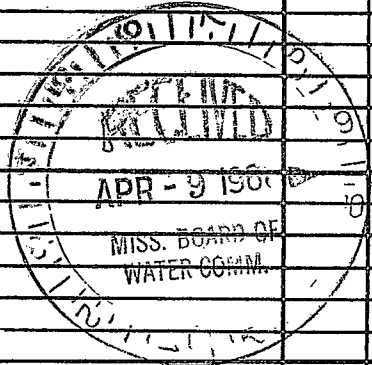

DRILLERS REMARKS:

If well telescopes please sketch and show depths.

GROUND LEVEL

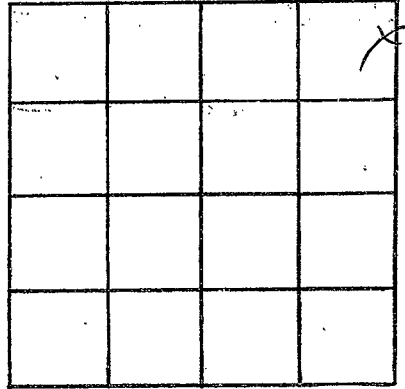

SECTION 34

Please indicate well location X.

ADDITIONAL INFORMATION

Lined area for additional information.

If more than one screen, show locations of each on sketch.