

PRENTISS
 C 2003
 3-68

MISSISSIPPI
 BOARD OF WATER COMMISSIONERS
 416 North State Street
 Jackson, Mississippi 39201

WATER WELL DRILLERS LOG

March 20 1968 Bonds Plumbing, Inc. Prentiss
 date well completed firm name county well located

LANDOWNER: Harding Barham
Route 1
Booneville
 (mailing address)

description of formations encountered	from	to
<u>Sand & clay</u>	<u>0</u>	<u>20'</u>
<u>Blue clay</u>	<u>20'</u>	<u>65'</u>
<u>Water sand</u>	<u>65'</u>	<u>110'</u>

WELL LOCATION:
 sec. 30 T. 4 N. R. 8 E.
5 miles West of Booneville
 (distance) (direction) (nearest town)

WELL PURPOSE: Home
 (home, irrigation, municipal, industrial)


- WELL COMPLETION DATA:
- diameter (inches) 4
 - total depth (feet) 110
 - static water level (feet) 30' ^{below} ~~above~~ top of ground.
 - casing steel, 23
 (material) (depth)
4 If telescope see back.
 (size)
 - screen none
 (length) (depth to top)
 (size) (material)
 - pump Chat Jet (HP) (yield gpm)
 (type power)
 - electric log no
 (yes or no)
 (organization running log)
 - how well bottom plugged open

DRILLERS REMARKS: He installed
Own Pump

MAY 28 1968
 MISS. B.D. CO.
 JAMES EDWARDS

If well telescopes please sketch and show depths.

GROUND LEVEL

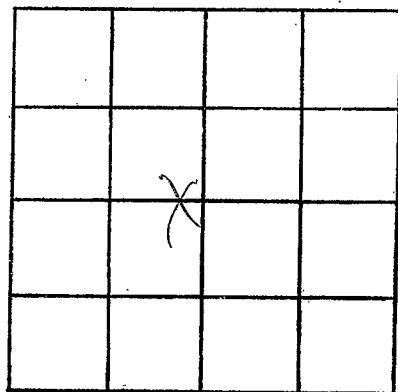

SECTION 30

Please indicate well location X.

ADDITIONAL INFORMATION

If more than one screen, show locations of each on sketch.