

Prentiss  
 C 2004  
 8-16-68

MISSISSIPPI  
 BOARD OF WATER COMMISSIONERS  
 416 North State Street  
 Jackson, Mississippi 39201

WATER WELL DRILLERS LOG

Aug 16 1968 Bonds Prentiss  
 date well completed firm name county well located

LANDOWNER: Randall Filipp  
Route 6  
Boonville, Miss  
 (mailing address)

WELL LOCATION:  
 sec. 27 T 4 N R 3 E  
7 miles NE of Boonville  
 (distance) (direction) (nearest town)


WELL PURPOSE: Home  
 (home, irrigation, municipal, industrial)

WELL COMPLETION DATA:  
 (1) diameter (inches) 4  
 (2) total depth (feet) 200  
 (3) static water level (feet) 40 below above top of ground.  
 (4) casing Steel, 42,  
 (material) (depth)  
~~4"~~ if telescope see back.  
 (size)  
 (5) screen none  
 (length) (depth to top)

(6) pump Red Iron Pump  
 (size) (material) (HP) (yield gpm)  
Edco  
 (type power)  
 (7) electric log no  
 (yes or no)  
 (organization running log)

(8) how well bottom plugged Open


Description of formations encountered	from	to
Red clay	0	8
Sandy " "	8	34
Sand	34	48
Blue clay	48	130
Water Band	130	200

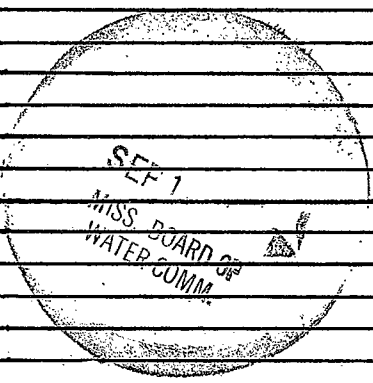

DRILLERS REMARKS:

If well telescopes please  
sketch and show depths.

GROUND LEVEL

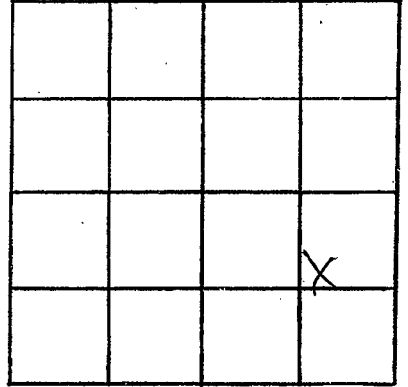

SECTION 27

Please indicate well location X.

ADDITIONAL INFORMATION

If more than one screen,  
show locations of each on sketch.