

Prentiss  
D 18  
9-9-69

MISSISSIPPI  
 BOARD OF WATER COMMISSIONERS  
 416 North State Street  
 Jackson, Mississippi 39201

**CODED**

WATER WELL DRILLERS LOG

9-9-69 date well completed 19 Layne-Central Company firm name Prentiss-Tishomingo county well located


LANDOWNER: Holcut-Cairo  
 Water District  
 (mailing address)  
 WELL LOCATION:  
 sec. 9 T 4 MX R 9 E  
 S \*  
8 miles SW Burnsville  
 (distance) (direction) (nearest town)

WELL PURPOSE: municipal  
 (home, irrigation, municipal, industrial)

WELL COMPLETION DATA:  
 (1) diameter (inches) 8"  
 (2) total depth (feet) 309'  
 (3) static water level (feet) 146' below  
 top of ground.  
 (4) casing steel, 255'  
 (material) (depth)  
8" if telescope see back.  
 (size)  
 (5) screen 50', 255'  
 (length) (depth to top)  
6" s. steel shutter  
 (size) (material)  
 (6) pump 25, 250  
 (HP) (yield gpm)  
electric  
 (type power)  
 (7) electric log yes  
 (yes or no)  
Schlumberger U.S.G.S  
 (organization running log)  
 (8) how well bottom plugged

description of formations encountered	from	to
Clay	0	35
Blue Clay	35	80
Rock	80	81
Sandy Shale	81	95
Shale	95	127
Rock	127	128
Shale	128	152
Shale-Sand Stks	152	212
Sandy Shale	212	233
Shale & Sand Stks.	233	253
Shale & Sand Stks.	253	273
Sand Gravel & Shale	273	305
Rock	305	311
White Clay	311	333

**CODED**

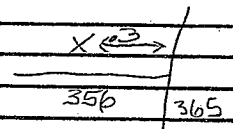


DRILLERS REMARKS:

WATER

②

If well telescopes please sketch and show depths.

GROUND LEVEL

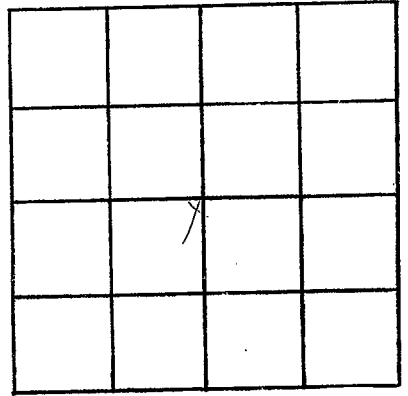

SECTION 9

Please indicate well location X.

ADDITIONAL INFORMATION

If more than one screen, show locations of each on sketch.