

CODED ✓

PRENTISS
D20
8-13-69

MISSISSIPPI
BOARD OF WATER COMMISSIONERS
416 North State Street
Jackson, Mississippi 39201

WATER WELL DRILLERS LOG

8-13 1969 Bond Well Drilling, Prentiss
date well completed firm name county well located
McGAUGHY S

LANDOWNER: Billy McGaughy

description of formations encountered

Boonville
(mailing address)

	from	to
Yellow sand	0	50
Blue sand	50	95
sandy blue clay	95	250
Water sand	250	320

WELL LOCATION:
sec. 7 T 4 N R 9 E
2 miles East of Jacinto
(distance) (direction) (nearest town)

WELL PURPOSE: Normal
(home, irrigation, municipal, industrial)

WELL COMPLETION DATA:

- (1) diameter (inches) 4
- (2) total depth (feet) 320
- (3) static water level (feet) 160 below above top of ground.
- (4) casing Steel, 105 (material) (depth)
(size) if telescope see back.
- (5) screen Non (length) (depth to top)
(size) (material)
- (6) pump (HP) (yield gpm)
(type power)
- (7) electric log No (yes or no)
(organization running log)
- (8) how well bottom plugged open


CODED

8-13-69

DRILLERS REMARKS:

If well telescopes please sketch and show depths.

GROUND LEVEL

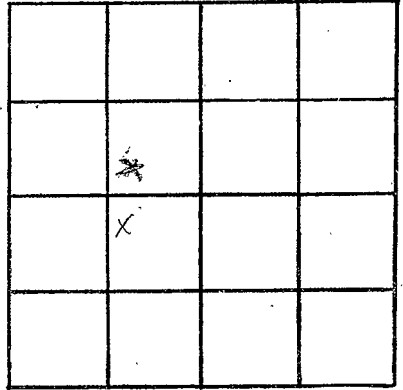

SECTION _____

Please indicate well location X.

ADDITIONAL INFORMATION

If more than one screen, show locations of each on sketch.