

MISSISSIPPI
BOARD OF WATER COMMISSIONERS
416 North State Street
Jackson, Mississippi 39201

CODED

WATER WELL DRILLERS LOG

PRENTISS
D 21
12-4-70

12-4 1970 Bond Well Drilling Prentiss
date well completed firm name county well located

L-1st 40 on 1/2

LANDOWNER: J. V. Burcham
Brownsville Miss
(mailing address)

description of formations encountered	from	to
<u>Gravel clay</u>	<u>0</u>	<u>16</u>
<u>Blue clay</u>	<u>16</u>	<u>83</u>
<u>Water sand</u>	<u>83</u>	<u>130</u>

WELL LOCATION:
sec. 21 T 4 N R 9 E
16 miles East of Brownsville
(distance) (direction) (nearest town)

WELL PURPOSE: Home
(home, irrigation, municipal, industrial)

- WELL COMPLETION DATA:
- (1) diameter (inches) 4
 - (2) total depth (feet) 130
 - (3) static water level (feet) 40 below above top of ground.
 - (4) casing Steel 21
(material) (depth)
 - if telescope see back.
(size)
 - (5) screen None
(length) (depth to top)
 - (size) (material)
 - (6) pump (HP) (yield gpm)
Had on pump
(type power)
 - (7) electric log no
(yes or no)
 - (organization running log)
 - (8) how well bottom plugged Open

CODED


JAN 7 1971

MISS. ED. OF
STATE WATER

DRILLERS REMARKS:

If well telescopes please sketch and show depths.

GROUND LEVEL

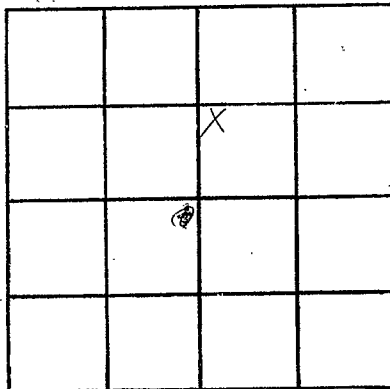

SECTION 21

Please indicate well location X.

ADDITIONAL INFORMATION

If more than one screen, show locations of each on sketch.