

MISSISSIPPI DEPARTMENT OF NATURAL RESOURCES

Bureau of Land and Water Resources

Southport Mall

P.O. Box 10631

Jackson, Mississippi 39209

WATER WELL DRILLERS LOG **CODED**

PRENTISS
D38
12-15-81

Dec 15 19 81  
date well completed

J.W. Madsen  
firm name

PRENTISS  
county well located

LANDOWNER: Holcut - Cairo  
Water Association  
Burnsville, Miss  
(mailing address)

description of formations encountered	from	to
SAND & CLAY	0	60
GRAY SAND CLAY STK.	60	120
Blue CLAY	120	180
SANDY CLAY	180	240
GRAY SAND	240	330
SAND / ROCK / Shell	330	360
Red CLAY	360	400
Med. GRAYel	400	415
ROCK	415	450

WELL LOCATION:  
sec. 8 T 4 N R. 9 E  
1/2 miles W of Holcut  
(distance) (direction) (nearest town)

WELL PURPOSE: R. W. A.  
(home, irrigation, municipal, industrial)

- WELL COMPLETION DATA:
- (1) diameter (inches) 12"
  - (2) total depth (feet) 450'
  - (3) static water level (feet) 182 <sup>below</sup> above top of ground.
  - (4) casing Steel 390  
(material) (depth)
  - (size) if telescope see back.
  - (5) screen 50' 370'  
(length) (depth to top)  
8" S.S.  
(size) (material)
  - (6) pump 25 250  
(HP) (yield gpm)  
E/C  
(type power)
  - (7) electric log yes  
(yes or no)  
MPCS  
(organization running log)

(8) how well bottom plugged BACK WASH  
NAIVE

DRILLERS REMARKS:

DEPT. OF NATURAL RESOURCES  
BUREAU OF LAND & WATER RESOURCES


APR 19 1982

RECEIVED

①

If well telescopes please sketch and show depths.

GROUND LEVEL

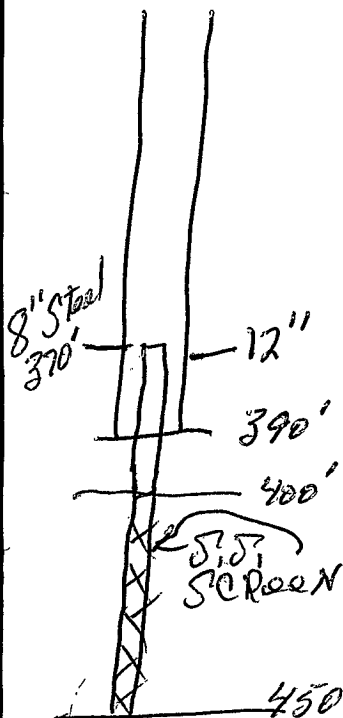


SECTION \_\_\_\_\_

Please indicate well location X.

ADDITIONAL INFORMATION

If more than one screen, show locations of each on sketch.