

PRENTISS

D 2000

MISSISSIPPI BOARD OF WATER COMMISSIONERS  
416 North State Street  
Jackson, Mississippi 39201

WATER WELL DRILLERS LOG

11/30/80

11-30-80

Bonds Well Drilling  
firm name

Prentiss  
county well located

date well completed

LANDOWNER: Harbert Russell  
Booneville, MS.

description of formations encountered

from

to

0-45 Red clay  
45-100 Water sand

(mailing address)

WELL LOCATION:

sec. 34 T 4 N R 9 E  
S W

8 miles NE of Booneville  
(distance) (direction) (nearest town)

WELL PURPOSE: Home  
(home, irrigation, municipal, industrial)

WELL COMPLETION DATA:

- (1) diameter (inches) 4"
- (2) total depth (feet) 100
- (3) static water level (feet) 20 below top of ground. above

(4) casing Plastic  
(material) (depth)

(size) If telescope see back.

(5) screen Perforated 100 ft.  
(length) (depth to top)

4" Plastic  
(size) (material)

(6) pump 3/4 10 gal/min  
(HP) (yield/gpm)

Elec.  
(type power)

(7) electric log NO  
(yes or no)

(organization running log)

(8) how well bottom plugged plugged

DEPT. OF NATURAL RESOURCES  
BUREAU OF LAND & WATER RESOURCES


MAY 19 1981

DRILLERS REMARKS:

RECEIVED

If well telescopes please sketch and show depths.

GROUND LEVEL

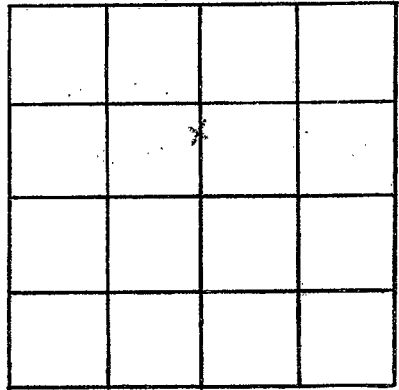

SECTION \_\_\_\_\_

Please indicate well location X.

ADDITIONAL INFORMATION

If more than one screen, show locations of each on sketch.