

PRENTISS

E

MISSISSIPPI BOARD OF WATER COMMISSIONERS

5-18-66

WATER WELL DRILLERS LOG

Date: May 18, 1966, Driller: Sally Bonds County: Prentiss
(When well drilled) (Name) (Where well is located)

	Description & Color of Materials Sand, Clay, Red Clay, Shell, etc.	Thick- ness Feet	Depth Feet
(1) Owner of Land: <u>R.H. Houston</u> (Name) <u>Booneville Miss</u> (Address)			
(2) Location: <u>1/4, 1/4, Sec. T R</u> <u>7</u> miles <u>Sweet</u> of <u>Booneville</u> (distance) (direction) (Nearest Town)			
(3) Topography: <u>Hilly</u> (Hilly) (Flat) (Level)			
(4) Purpose of Well: <u>Domestic</u> (Domestic Irrigation Municipal, Industrial, Other)			

18' to blue
sand casing
Cased 84 ft

Information upon completion of well:

(1) Diameter 4 inches.

(2) Total Depth 150 feet.

(3) Water Level 34 feet below top of ground.

(4) Cased to 84, Size 4 "


(5) Screen: Size , Length .

(6) Were any formations sealed against pollution?
_____ yes, _____ no.

Rack 118 ft 1 1/2 ft
Then Water Sand

If YES depth of formation _____
Why _____

Drillers Remarks: _____
Yield in gpm: 8 gpm
Size pump: 1/2 horse
Type power: Steel Trip

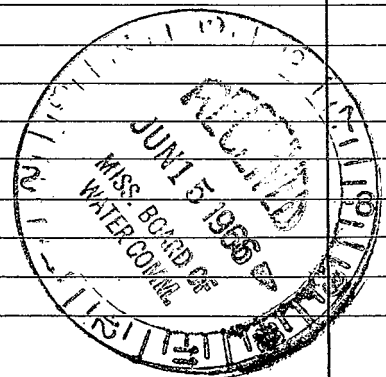

Mail this copy to Board of Water Commissioners 429 Miss. St. Jackson, Miss.

