

PRENTISS

E

MISSISSIPPI BOARD OF WATER COMMISSIONERS

5-20-66

WATER WELL DRILLERS LOG

Date: May 20, 1966, Driller: Sands & Dilling Co., Prentiss (When well drilled) (Name) (Where well is located)

(1) Owner of Land: Duane Pinchard (Name) Booneville (Address)

(2) Location: 1/4, 1/4, Sec. T R, 7 1/4 miles West Booneville, (distance) (direction) (Nearest Town)

(3) Topography: Hilly (Hilly) (Flat) (Level)

(4) Purpose of Well: Domestic (Domestic Irrigation Municipal, Industrial, Other)

Table with 3 columns: Description & Color of Materials, Thickness Feet, Depth Feet. Contains handwritten entries: Sand, Clay, Red Clay, Shell, etc.


Information upon completion of well:

- (1) Diameter 4 inches. (2) Total Depth 150 feet. (3) Water Level 28 feet below top of ground. (4) Cased to 84, Size 4". (5) Screen: Size, Length. (6) Were any formations sealed against pollution? yes, no.

20 ft to blue casing sand to 80 ft. 84 ft to next blue rock 120 ft water sand under rock.

If YES depth of formation Why

Drillers Remarks: Yield in gpm: 8" Size pump: FXD 1/2 horse Type power: Elec

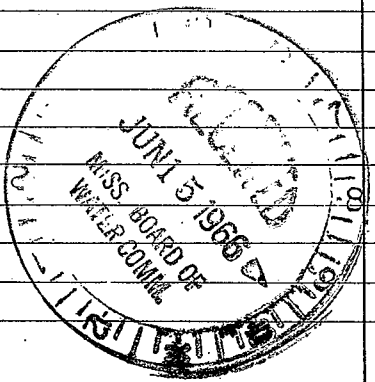

Just send more on what needs  
to have as soon as possible