

Prentiss

E

MISSISSIPPI BOARD OF WATER COMMISSIONERS

5-21-66

WATER WELL DRILLERS LOG


Date: May 21, 1966, Driller: Bonds P L Drilling Co, County: Prentiss

Owner of Land: Mrs George Moore, Booneville Miss; Location: 6 miles west of Booneville; Topography: Hilly; Purpose of Well: Domestic

Table with 3 columns: Description & Color of Materials, Thickness Feet, Depth Feet. Entries include 19 ft Sand, 21 ft blue, blue shell 80, water sand to bottom.

Information upon completion of well: (1) Diameter 4 inches, (2) Total Depth 135 feet, (3) Water Level 65 feet below top of ground, (4) Cased to 21, Size 4 inch, (5) Screen: Size, Length, (6) Were any formations sealed against pollution?

Why: It sitting 85 ft; Drillers Remarks; Yield in gpm: 5 gpm; Size pump: J.P.D. 3/4; Type power: Electric

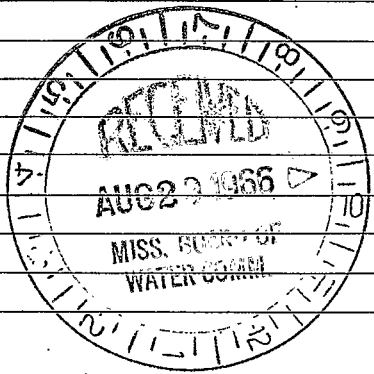

Mail this copy to Board of Water Commissioners 429 Miss. St. Jackson, Miss.

