

PRENTISS
E 31
10-23-69

MISSISSIPPI
 BOARD OF WATER COMMISSIONERS
 416 North State Street
 Jackson, Mississippi 39201

CODED

WATER WELL DRILLERS LOG

10-23 1969 Bondie Well Drilling Prentiss
 date well completed firm name county well located

LANDOWNER: Leary Agriest
Boomerwell
 (mailing address)

description of formations encountered	from	to
<u>Yellow sand</u>	<u>0</u>	<u>35</u>
<u>orange shale</u>	<u>35</u>	<u>78</u>
<u>blue clay</u>	<u>78</u>	<u>140</u>
<u>blue sand</u>	<u>140</u>	<u>190</u>

WELL LOCATION:
 sec 35 T 5 N R 6 E
4 miles West of Boomerwell
 (distance) (direction) (nearest town)

WELL PURPOSE: Home
 (home, irrigation, municipal, industrial)

- WELL COMPLETION DATA:
- (1) diameter (inches) 4
 - (2) total depth (feet) 190
 - (3) static water level (feet) 30 ^{below} above top of ground.
 - (4) casing Steel 84
 (material) (depth)
 (size) if telescope see back.
 - (5) screen none
 (length) (depth to top)
 (size) (material)
 - (6) pump 3/4 6
 (HP) (yield gpm)
1/2
 (type power)
 - (7) electric log no
 (yes or no)
 (organization running log)
 - (8) how well bottom plugged open


NOV 20 1969

DRILLERS REMARKS:

MISSISSIPPI
 BOARD OF WATER COMMISSIONERS

If well telescopes please sketch and show depths.

GROUND LEVEL

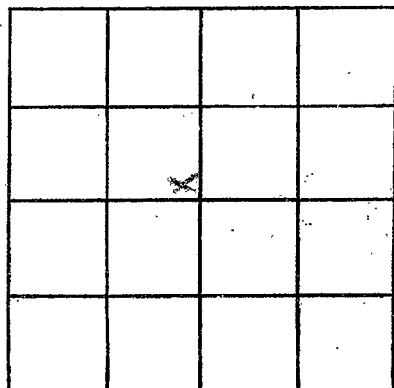

SECTION _____

Please indicate well location X.

ADDITIONAL INFORMATION

If more than one screen, show locations of each on sketch.