

**MISSISSIPPI  
BOARD OF WATER COMMISSIONERS**  
416 North State Street  
Jackson, Mississippi 39201

**COPIED**

**Prentiss**

**E 32**

**2-11-70**

**WATER WELL DRILLERS LOG**

2-11 1970 Bonds Well Drilling Prentiss  
date well completed firm name county well located

LANDOWNER: R. C. Cantelero description of formations encountered

	from	to
<u>Brownville Miss.</u> <small>(mailing address)</small>	<u>0</u>	<u>10</u>
	<u>10</u>	<u>45</u>
	<u>45</u>	<u>150</u>
	<u>150</u>	<u>190</u>

WELL LOCATION:  
 sec. 16 T. 5 N. R. 6 E  
5 miles West of Brownville  
(distance) (direction) (nearest town)

WELL PURPOSE: None  
(home, irrigation, municipal, industrial)

**WELL COMPLETION DATA:**

- (1) diameter (inches) 4
- (2) total depth (feet) 190
- (3) static water level (feet) 57 below above top of ground.
- (4) casing Steel 50  
(material) (depth)  
(size) If telescope see back.
- (5) screen None  
(length) (depth to top)  
(size) (material)
- (6) pump None None  
(HP) (yield gpm)  
(type power)
- (7) electric log Yes  
(yes or no)  
(organization running log)
- (8) how well bottom plugged Open

**COPIED**


MAR 2 - 1970

MISS. Bd. of WATER COMMISSIONERS

DRILLERS REMARKS:

If well telescopes please sketch and show depths.

GROUND LEVEL

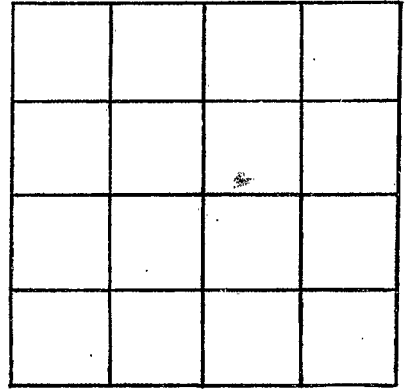

SECTION \_\_\_\_\_

Please indicate well location X.

ADDITIONAL INFORMATION

If more than one screen,  
show locations of each on sketch.