

Prentiss  
E 33  
3-30-70

MISSISSIPPI  
BOARD OF WATER COMMISSIONERS  
416 North State Street  
Jackson, Mississippi 39201

CODING

WATER WELL DRILLERS LOG

3-30 1970 Bond's Well Drilling Prentiss  
date well completed firm name county well located

LANDOWNER: James Miller

description of formations encountered

from to

Bonnaville  
(mailing address)

mesquite sand 0 15  
blue clay 15 100  
iron sand 100 140

WELL LOCATION:

sec. 22 T. 5 N. R. 6 E.  
5 miles S-W of Bonnaville  
(distance) (direction) (nearest town)

WELL PURPOSE: Home  
(home, irrigation, municipal, industrial)

WELL COMPLETION DATA:

- (1) diameter (inches) 4
- (2) total depth (feet) 140
- (3) static water level (feet) 50 below above top of ground.
- (4) casing Steel 21  
(material) (depth)  
(size) If telescope see back.
- (5) screen none  
(length) (depth to top)  
(size) (material)
- (6) pump 3/4 5  
(HP) (yield gpm)  
Electric Pump  
(type power)
- (7) electric log no  
(yes or no)

CODING

(organization running log)

(8) how well bottom plugged open


APR 13 1970

DRILLERS REMARKS:

DRILLER'S SIGNATURE

If well telescopes please sketch and show depths.

GROUND LEVEL

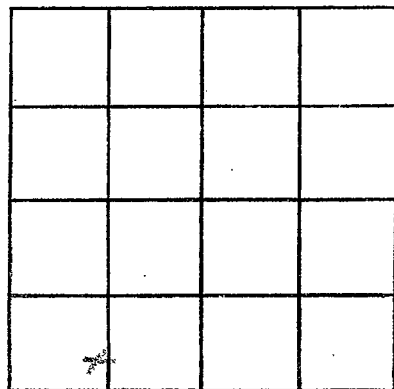

SECTION \_\_\_\_\_

Please indicate well location X.

ADDITIONAL INFORMATION

If more than one screen,  
show locations of each on sketch.