

Prentiss
E 34
4-7-70

MISSISSIPPI
BOARD OF WATER COMMISSIONERS
416 North State Street
Jackson, Mississippi 39201

WATER WELL DRILLERS LOG

4-7 1970 Bonds Well Drilling Prentiss
d. well completed firm name county well located

LANDOWNER: Oak Ridge, Chas...

description of formations encountered

Brownville, Miss
(mailing address)

description of formations encountered	from	to
casement	0	35
shale & blue	35	200
water sand	200	260

WELL LOCATION:
sec. 20 T 5 N R 6 E
5 miles S.W. of Brownville
(distance) (direction) (nearest town)

WELL PURPOSE: 1/2 acre
(home, irrigation, municipal, industrial)

WELL COMPLETION DATA:

- (1) diameter (inches) 4
- (2) total depth (feet) 260
- (3) static water level (feet) 105 below top of ground.
- (4) casing (material) steel (depth) 42
(size) if telescope see back.
- (5) screen (length) none (depth to top) none
(size) (material)
- (6) pump 2 (HP) 5 (yield gpm)
1/2 (type power)
- (7) electric log no (yes or no)
(organization running log)
- (8) how well bottom plugged open


DRILLERS REMARKS:

MAY 4 1970

MISS. Bd. OF
WATER COM.

If well telescopes please sketch and show depths.

GROUND LEVEL

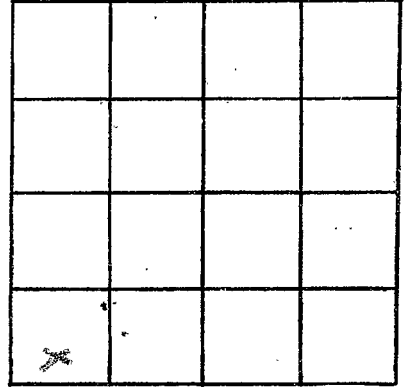

SECTION _____

Please indicate well location X.

ADDITIONAL INFORMATION

If more than one screen,
show locations of each on sketch.